WATER SERVICE RECORD

Name | **Service No.**

Address 12 Waltham ST

Location 10J-34 - Pg 48

Repair—Renewal—New Service Guarese

Date		Material	Amount		Total		Date			Amount	
8-16-11	9.4	1.5" copper									
	1	1.5 - corpt									
	1	Saddle - 1.5									
	1	1.5 - Curb STop									
		1.5 x 2" - dresser-coupling									
Existing		2" - Cast Iron To Build									

DATE _____

TOWN OF LEXINGTON — BOARD OF PUBLIC WORKS

WATER DIVISION

Sketch of Service Here

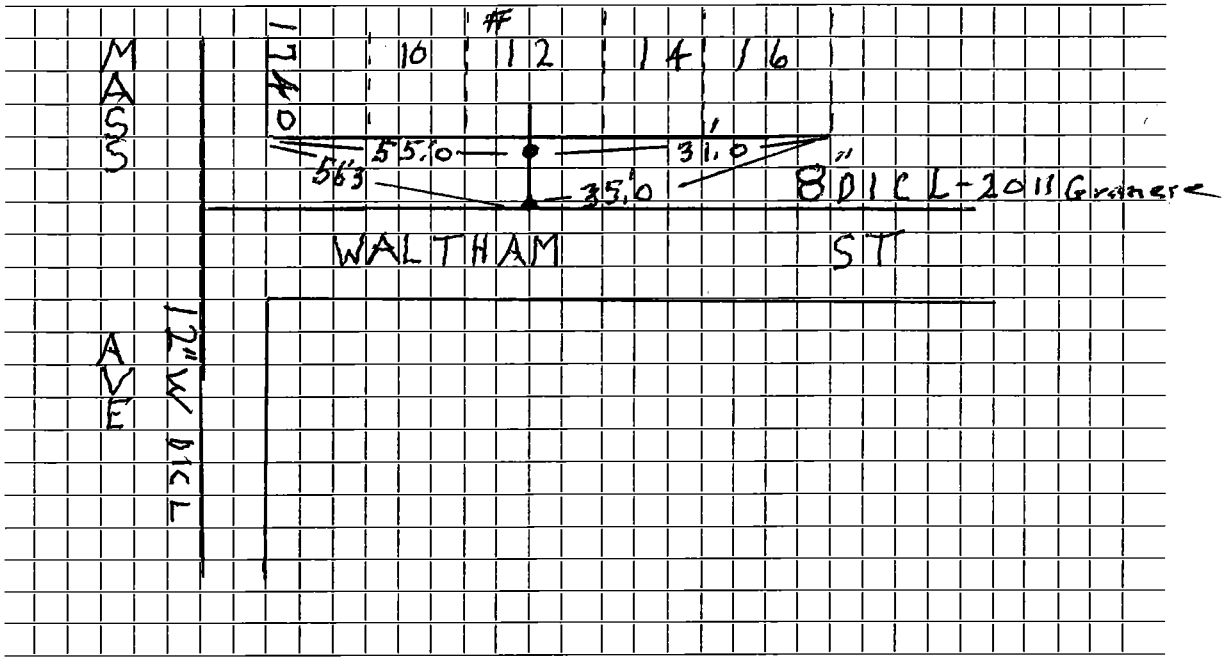

Connection made in ..... Street. Work completed 8/16/11 Grannen

Remarks: .....

.....

.....