WATER SERVICE RECORD

Name | **Service No.**

Address 188 Waltham street

Location 40-C-18T

Repair—Renewal—New Service Main to Curbstop 8122/12 Granese

Date		Material	Amount	Total	Date		Amount
8-22-12	28'	1" Copper					
		1" Corp					
		1" Curb					
		1x3/4 Union					
		buffalo box					
Exist							
1948	42'	3/4" Copper To house					
		3/4x1/2-S-W					

DATE _____

TOWN OF LEXINGTON — BOARD OF PUBLIC WORKS

WATER DIVISION

Sketch of Service Here

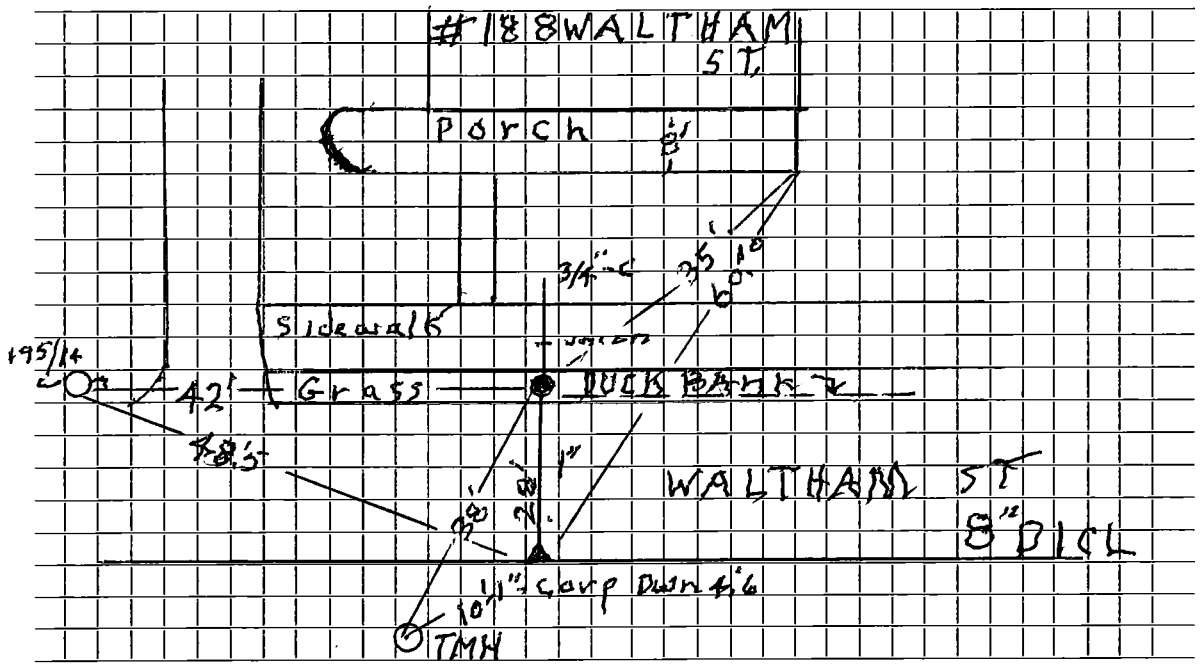

Connection made in ..... Street. Work completed 8-22-12 - Grasse

Remarks: Curb 4'7 Down

.....

.....