WATER SERVICE RECORD

Name | **Service No.**

Address 201 Waltham street

Location 40-228-lot

Repair—Renewal—New Service Main to curbstop 8/13/12 Grange

Date		Material	Amount	Total	Date		Amount
8-13-12	7'	1" Copper					
		1" - Corp					
		1" Curb Stop	(Resp Exist 3/4" curb)				
		1x3/4 Union					
		buffalo box					
Exist	47'	3/4" Copper To house					
1959		3/4" - Saws					

DATE _____

TOWN OF LEXINGTON — BOARD OF PUBLIC WORKS

WATER DIVISION

Sketch of Service Here

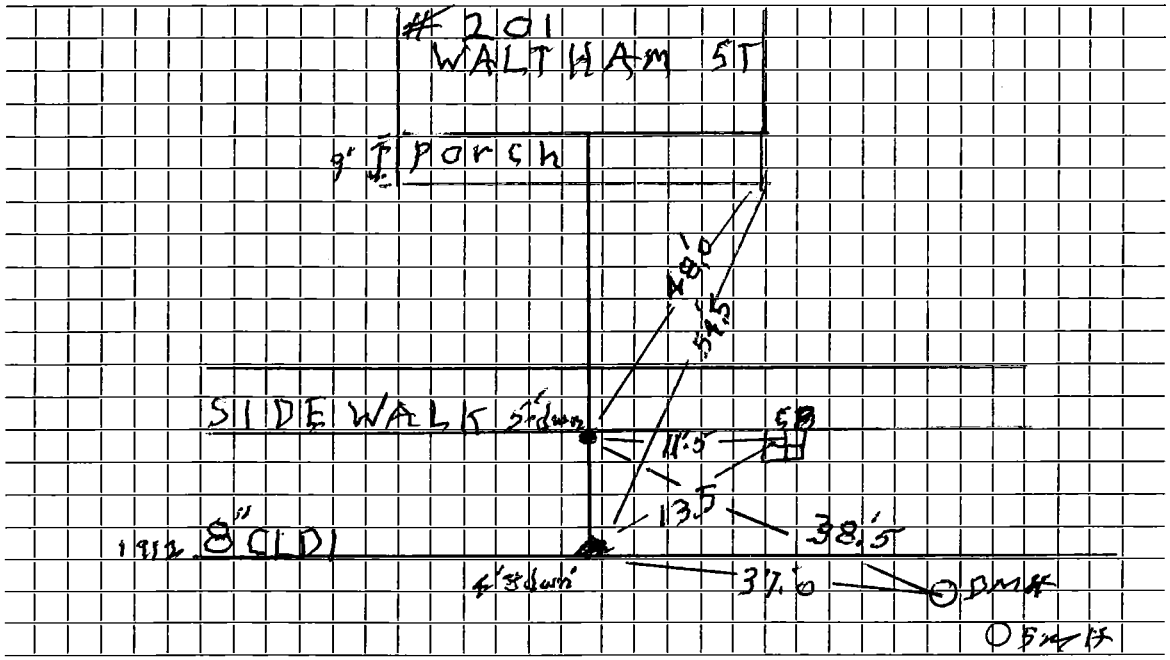

Connection made in ..... Street. Work completed 8-13-12

Remarks: .....

.....

.....