WATER SERVICE RECORD

Name | **Service No.**

Address 31 Waltham ST

Location J&T 33B Pg 89

Repair—Renewal—New Service Grancer

Date		Material	Amount	Total	Date		Amount
8-12-11	4.5	1" Copper + Union					
		1" Corp					
Exist	1965	1" Curb Stop + box + rod					
8-12-11	—	1" - Union					
Exist	1965	1" Copper To build.					

DATE _____

TOWN OF LEXINGTON — BOARD OF PUBLIC WORKS

WATER DIVISION

Sketch of Service Here

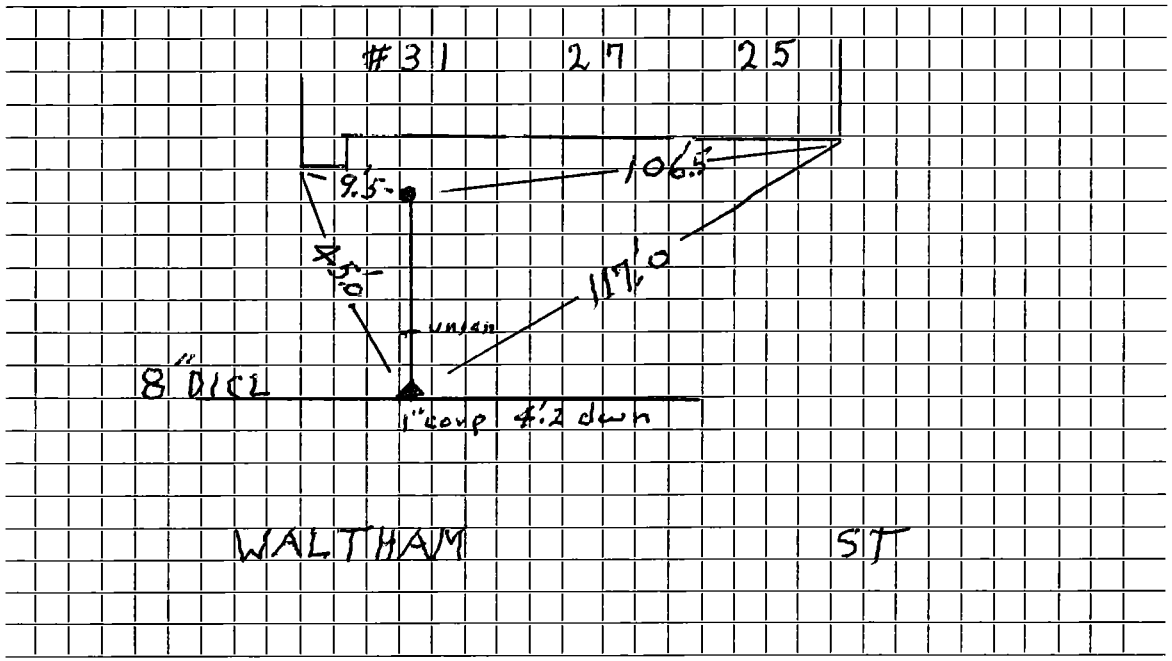

Connection made in ..... Street. Work completed 8-12-11 Graves

Remarks: Exist 1" curb left in Place

.....

.....