WATER SERVICE RECORD

Name

Service No.

Address 333 Waltham ST

Location

Lot 272

Repair—Renewal—New Service P.A.O Corp

Date		OUT Material IN ST.	Amount	Total	Date		Amount
11/19/09	43'	1" Plastic Pipe					
	1'	1" Plastic Pipe					
	1	1"X1" Union					
	1	1" Corp	5.2" Down				
		1" Curb Stop	5.3 Down				
		bufflobox					
		Existing To house					
		1" Copper					

DATE _____

TOWN OF LEXINGTON — BOARD OF PUBLIC WORKS

WATER DIVISION

Sketch of Service Here

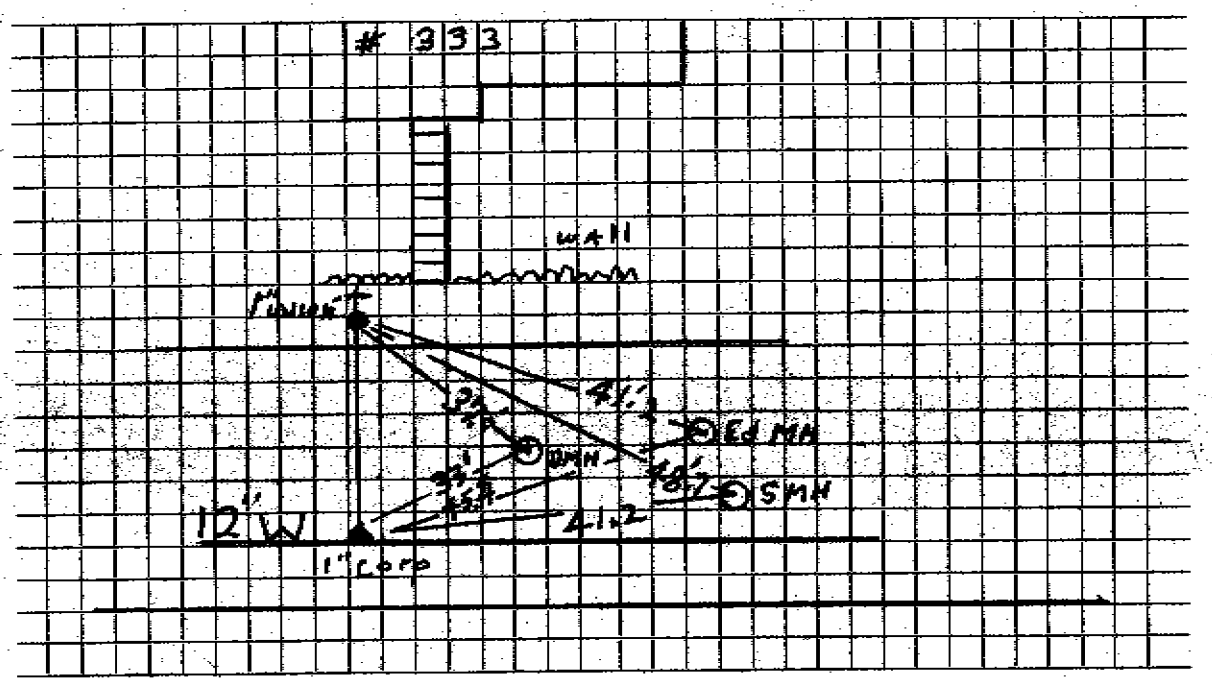

Connection made in ..... Street. Work completed .....

Remarks: 1" Plastic Pipe Corp To Curb