WATER SERVICE RECORD

Name | **Service No.**

Address 365 Waltham ST

Location LoT 268

Repair—Renewal—New Service out

Date		Material	Amount	Total	Date		Tap on 12" W-PAO. Corp	Amount
11/26/46	77'	3/4 Copper			11/23/07			
	1	3/4 × 1/2 Sew				435	1" Plastic Pipe	
	1	3/4 Union 2 Parts				1	1" corp	
						1	1" Curb stop	
						1	1" x 3/4 Red.	
							buffalo box	

DATE

TOWN OF LEXINGTON — BOARD OF PUBLIC WORKS

WATER DIVISION

Sketch of Service Here

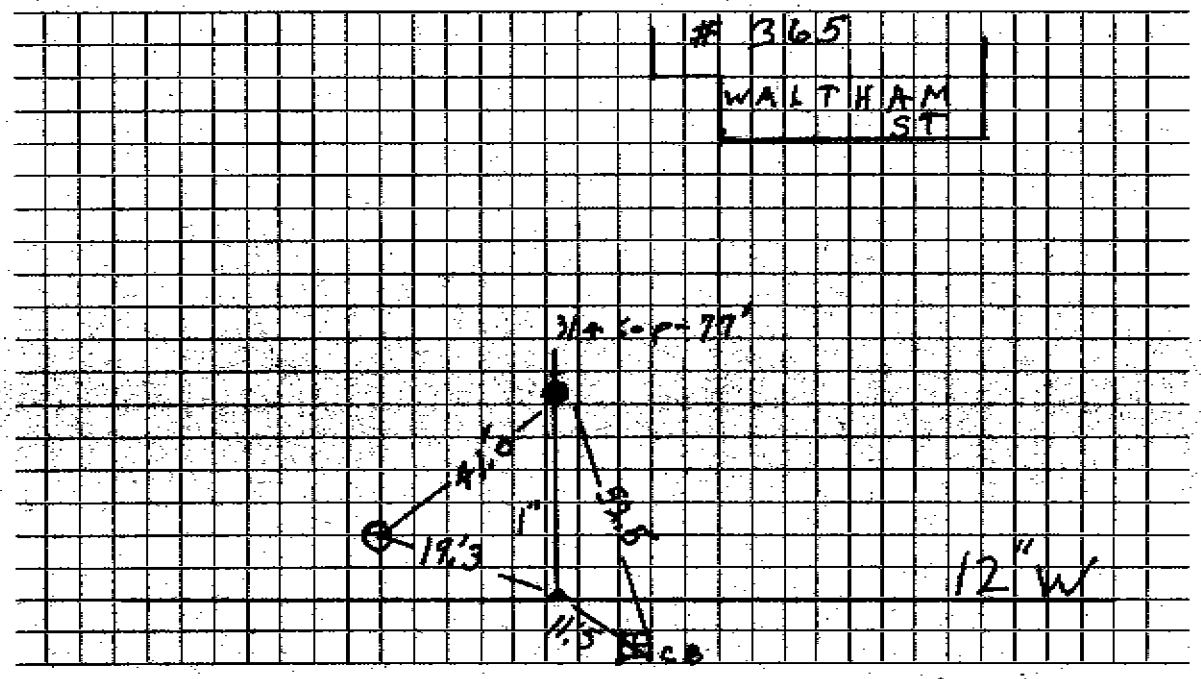

Connection made in Waltham ST Street. Work completed 11/23/09 PAO-Corp

Remarks: Plastic 1" Pipe Main To Curb Stop