WATER SERVICE RECORD

Name Dunkin Donuts

Service No.

Address 373 Waltham ST

Location 323 Marbett Rd + See Tie Card

Marbett Lot 267

Repair—Renewal—New Service Tap on Marbett RD

Date		Material	Amount		Total		Date			Amount	
9/30/70	49'						9/13/09	45'	1" Copper		
								1.5	1" Copper		
									1" Coup		
									1" Cock		
									1"x3/4 Red		
									buffalo box		

DATE _____

TOWN OF LEXINGTON — BOARD OF PUBLIC WORKS

WATER DIVISION

Sketch of Service Here

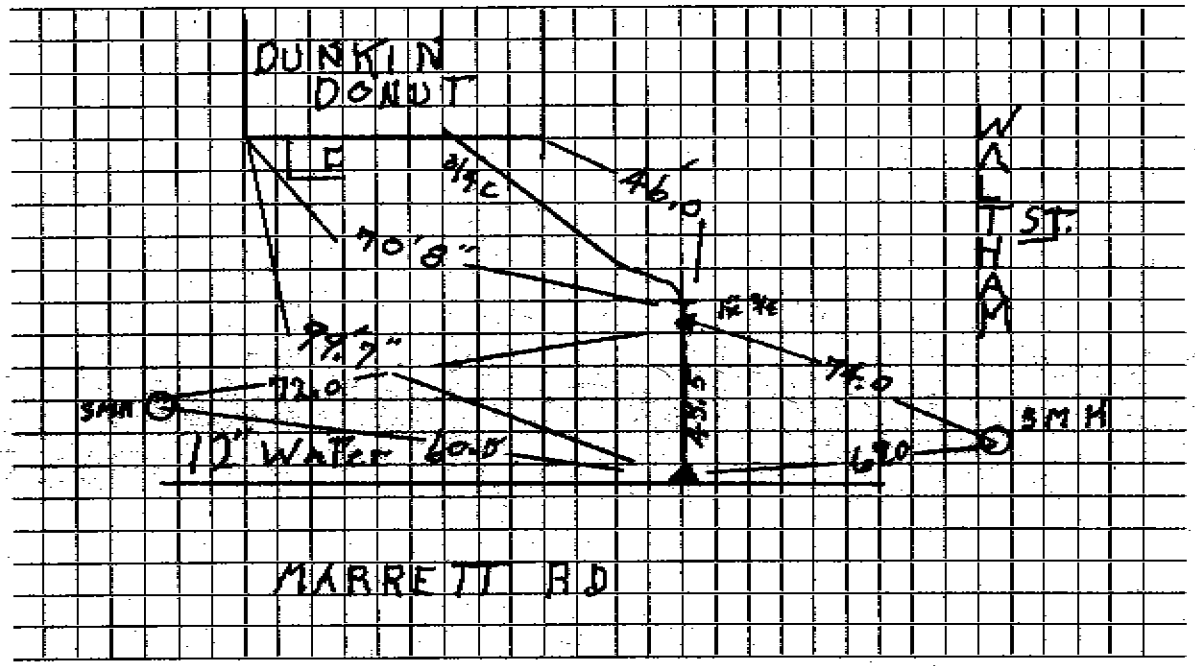

Connection made in Marrett Rd Street. Work completed 9/13/09 PAO Corp

Remarks: 12" Water - 6" A.B. To 342 Marrett