WATER SERVICE RECORD

Name | **Service No.**

Address 43 Waltham ST

Location NO's 41-To 49 bulk | lot 32/Pg 69

Repair—Renewal—New Service Granese

Date		Material	Amount	Total	Date		Amount
8/M/11	3	1" Corp's.					
	3·1	"6'+6+6'- L.F. Copper					
	3·	1"- Unions					
		2"- Curb left In Place					
1956	1	4 Way branch					
	1	2"- Jerkins Valve					
	1	2"- gate Valve					
		2" C.L.P.					

DATE _____

TOWN OF LEXINGTON — BOARD OF PUBLIC WORKS

WATER DIVISION

Sketch of Service Here

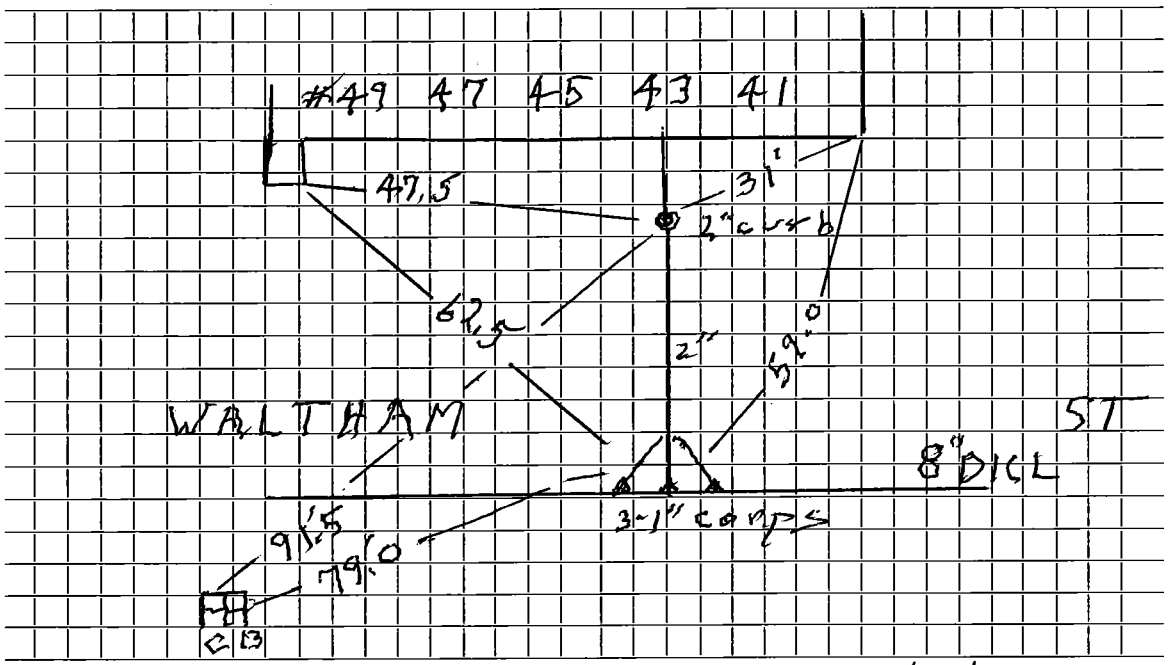

Connection made in ..... Street. Work completed 8/17/11 Grease

Remarks: 4-Way branch

.....

.....