H.B.M.15010

WATER SERVICE RECORD

Name Charlotte Maxner **Service No.** 16 M.D.

Address 462 Waltham Street

Location

~~Repair~~ XXXXXX—Renewal—~~New Service~~ XXXXXXXX

Date	Material	Amount	Total
10-3-56	Labor	7.80	
	10% O.H.	.78	8.58
	40' 3/4" Copper tubing @.4850		19.40
	1 3/4" Cx½ I.W.H.Stop & Waste		4.96
	1 hr. Trucking @ .75		.75
			33.69

Date		Amount
3-10-58	Paid	# 33.69
	NON CHARGE	
10-3-56	Labor	6.60
	20' 3/4" Copper tubing @.4850	9.70
	1 3/4" C Corp Cock	4.64
	1 3/4" C Curb Cock	5.94
	1 Box & Rod	4.62
	1½ Straight Tailpiece	.50
	1½ Offset Tailpiece	.50
		32.50

Bill sent 3/19/57

DATE _____

TOWN OF LEXINGTON — BOARD OF PUBLIC WORKS

WATER DIVISION

Sketch of Service Here

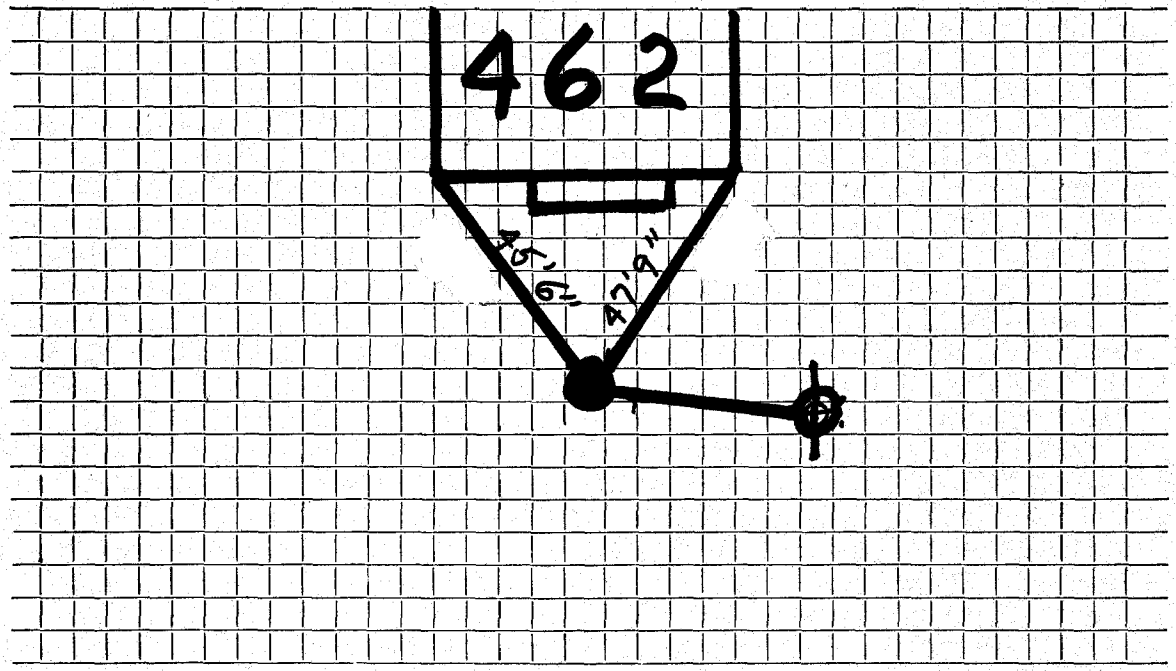

Connection made in ..... Street. Work completed .....

Remarks: .....

.....

.....