WATER SERVICE RECORD

Name **Service No.**

Address 52 Walthan ST

Location Lot 37/Pg-48

Repair—Renewal—New Service Grease

Date		Material	Amount	Total	Date		Amount
8-11-2011	9'	1" Copper					
		1" Corp					
		1" Curb Stop					
		1"x3/4 union					
		buffalo box					
Exist	3/4"	Copper To house					
1948		3/4x1/2 S+W					
NO-52	→	Feeds 52 Bin Rear					

DATE _____

TOWN OF LEXINGTON — BOARD OF PUBLIC WORKS

WATER DIVISION

Sketch of Service Here

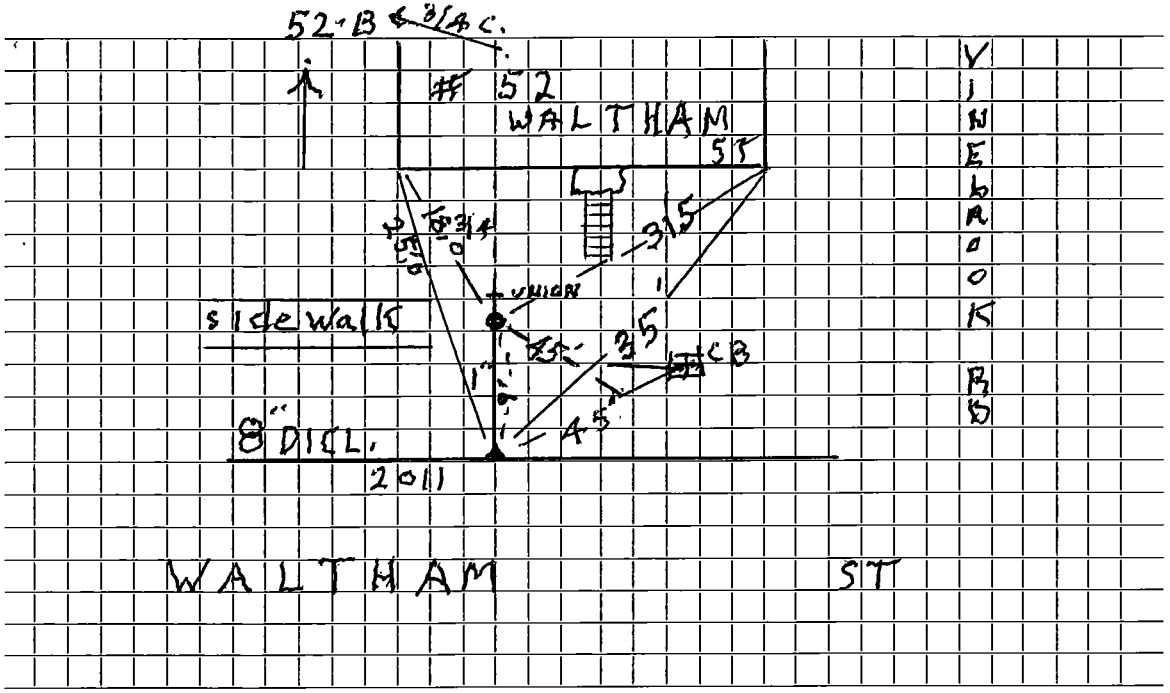

Connection made in ..... Street. Work completed 2011 Grease

Remarks: House No. 52 - Feed 52-B in rear

.....

.....