WATER SERVICE RECORD

Name | **Service No.**

Address 55 Waltham ST

Location Pg 49 Lot 31-B

Repair—Renewal—New Service Granger

Date		Material	Amount		Total		Date			Amount	
8-11-11	38'	1" Copper									
		1" Corp									
		1" Curb Stop									
		1" x 3/4 Union									
Exist		3/4" copper To bulk,									

DATE _____

TOWN OF LEXINGTON — BOARD OF PUBLIC WORKS

WATER DIVISION

Sketch of Service Here

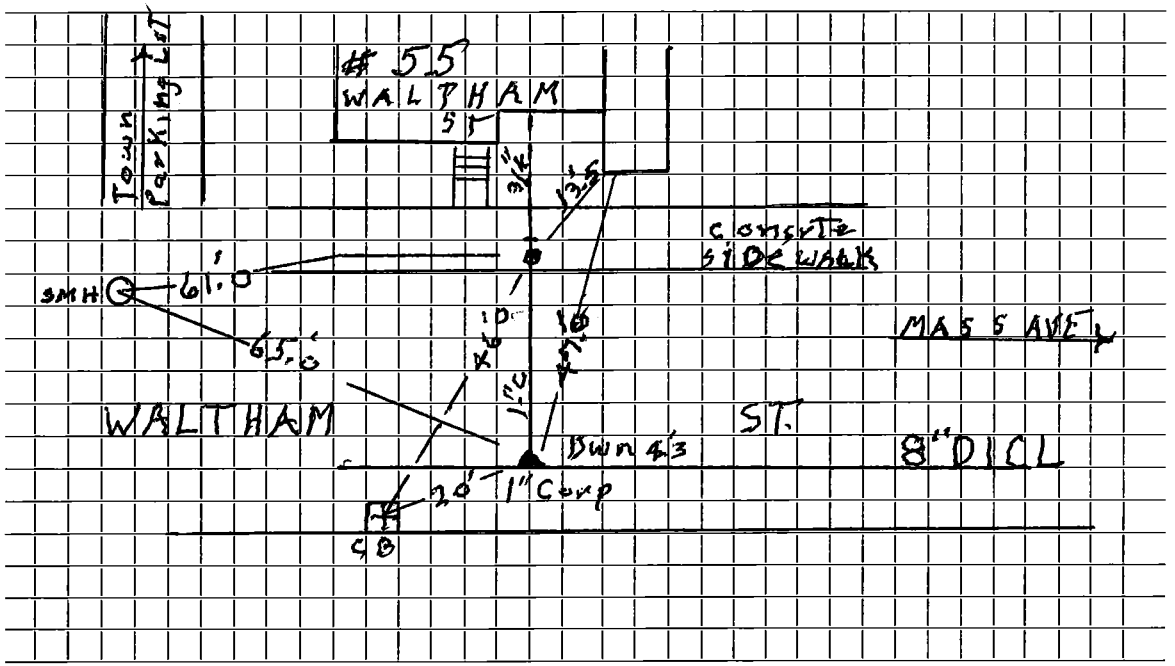

Connection made in ..... Street. Work completed .....

Remarks: .....

.....

.....