WATER SERVICE RECORD

Name *Robert E. Phelan* Service No.

Address 608 WALTHAM ST

Location

Repair—Renewal—(New Service) *Redmond #4734*

Date	Material	Amount	Total	Date		Amount
11/28 88	120' of 1" COPPER					
	c/c & BOX					
	UNION					

DATE _____

TOWN OF LEXINGTON — BOARD OF PUBLIC WORKS

WATER DIVISION

Sketch of Service Here

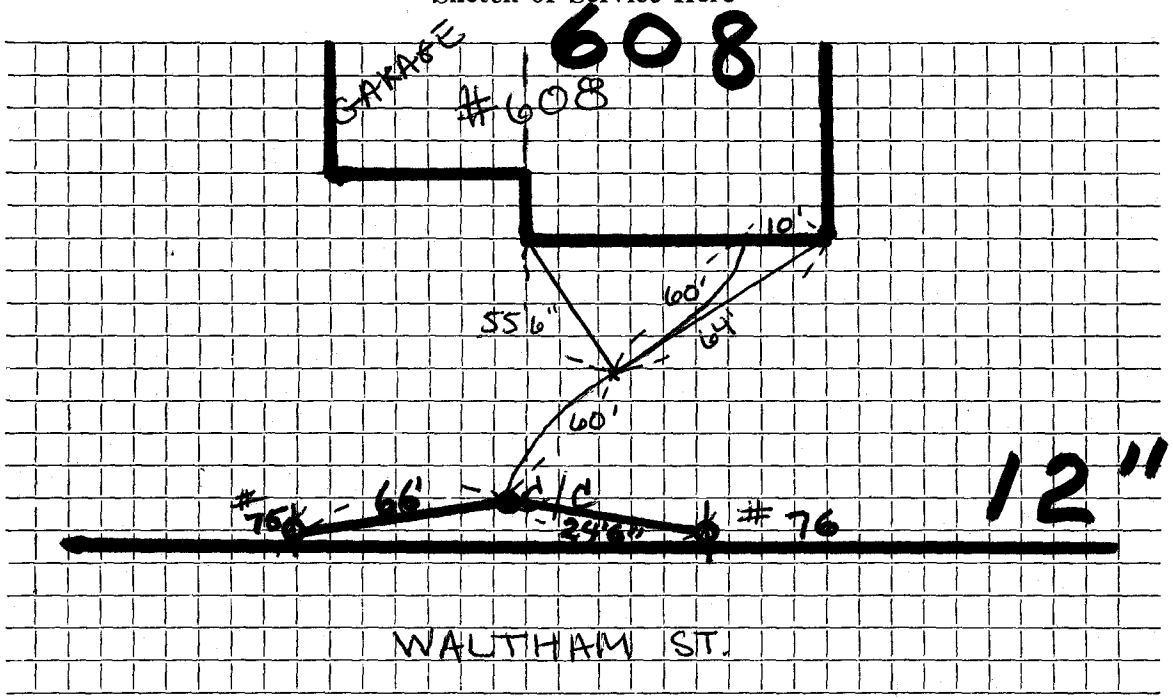

Connection made in WALTHAM ST. Street. Work completed .....

Remarks: NOTE: NO OUTSIDE TIES TAP 12" MAIN 8' dwn