# WATER SERVICE RECORD

**Name** BARTELL **Service No.**

**Address** #624 WALTHAM STREET

**Location**

**Repair** **Renewal** ~~**New Service**~~ PERMIT NO. 0962- PAUL ROSE

| Date | Material | Amount | Total | Date | | Amount |
|---|---|---|---|---|---|---|
| MAY 19, 1997 | 50' - 1"ϕ COPPER | | | | | |
| | | | | | Outside | |
| | | | | 5-23-75 | 7' 3/4" Copper | |
| | | | | | 1 3/4" Corp | |
| | | | | | 1 3/4" Curb Stop | |
| | | | | | 1 1" Repair Clamp | |
| | | | | | 1 Coupling | |
| | | | | | 1 Nipple | |

DATE MAY 19, 1997

TOWN OF LEXINGTON — BOARD OF PUBLIC WORKS

# WATER DIVISION

Sketch of Service Here

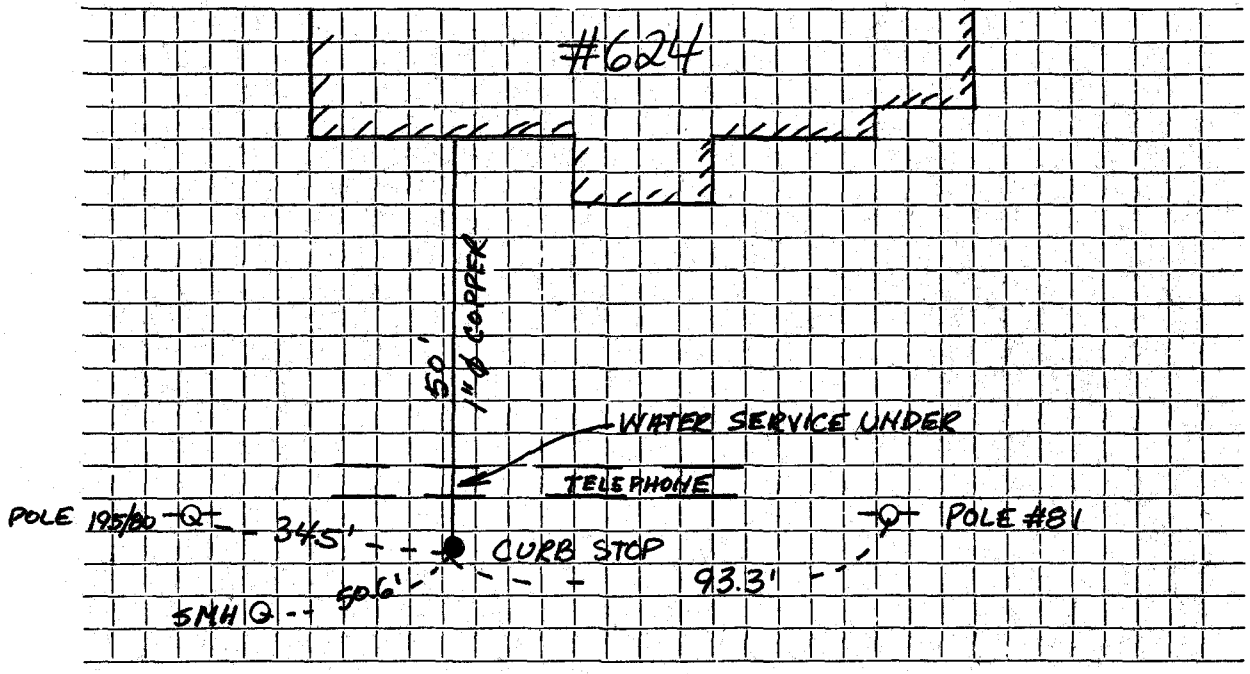


Connection made in WALTHAM STREET Street. Work completed PAUL ROSE

Remarks:

BOOK 97-2

J.W.