WATER SERVICE RECORD

Name **Service No.**

Address 72 Walthame ST

Location Pg 48 | 0 T 79

Repair—Renewal—New Service Granese

Date		Material	Amount		Total		Date			Amount	
8-8-11	9'	1" Copper									
		1" Corp									
		1" Curb Stop									
		1x3/4" Union									
		bufflo box									
Ex 15 T	1971										
[redacted]		3/4" Copper To house									
		3/4" Valve									

DATE

TOWN OF LEXINGTON — BOARD OF PUBLIC WORKS

WATER DIVISION

Sketch of Service Here

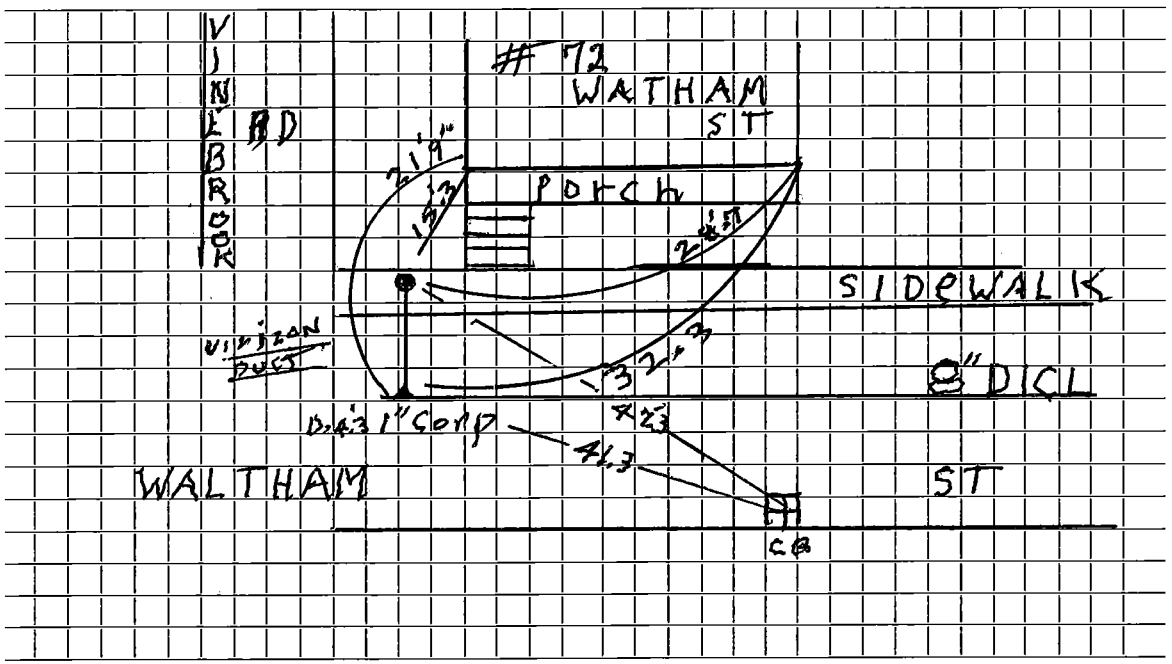

Connection made in Waltham St Street. Work completed 8/8/11 Granese

Remarks: