WATER SERVICE RECORD

Name *Hugh McDonald* Service No.

Address *740 Waltham Street*

Location

~~Repair~~ ~~Renewal~~—New Service *James McLaughlin #4364*

Date		Material	Amount		Total		Date			Amount	
4/30/87	*82.5*	*1" Copper*									
		1" Value									
									OUTSIDE		
							4/30/87	*12'*	*1" Copper*		
									1" Corp		
									1" Curb		
									Box & Rod		

DATE _____

TOWN OF LEXINGTON — BOARD OF PUBLIC WORKS

WATER DIVISION

Sketch of Service Here

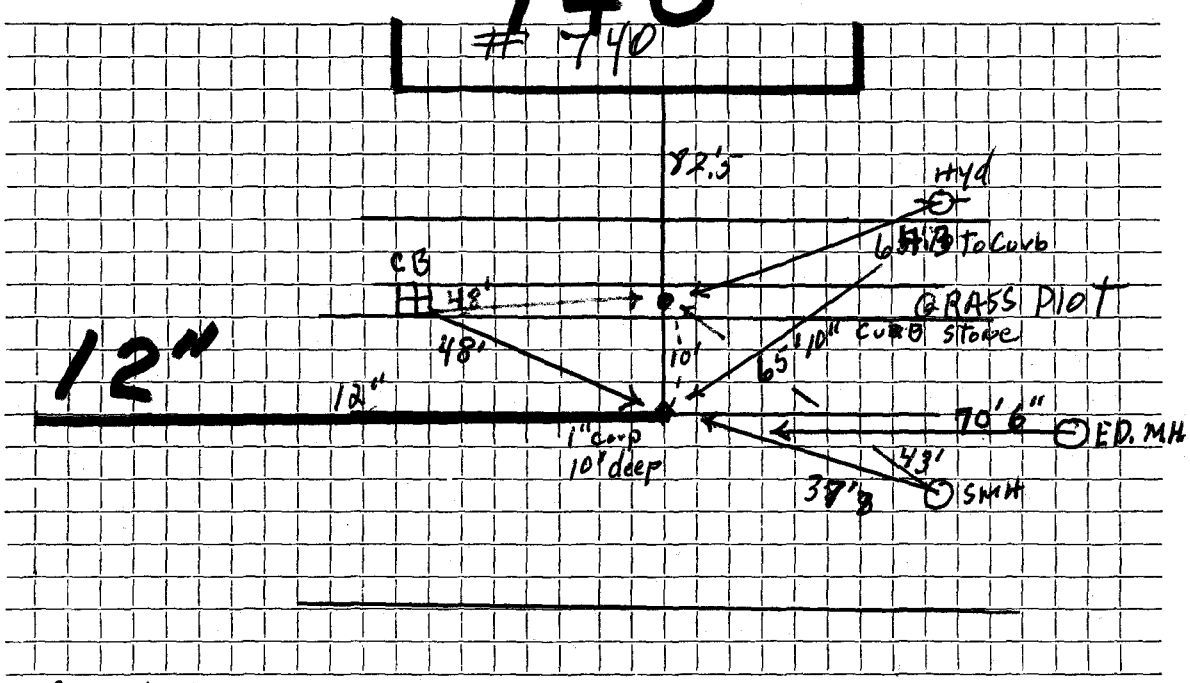

Connection made in Waltham ST Street. Work completed .....

Remarks: 12" Main 10' deep