WATER SERVICE RECORD

Name

Service No.

Address 99+101 WaTham ST

Location Pg 49-LoT 28

Repair—Renewal—New Service Granese

Date		Material	Amount	Total	Date		Amount
8-10-11	6.5'	1" Copper Connected To Exist 1" in St.					
		1"-Corp dan 4.7"					
		1"-Curb Stop					
		1"x1" Union					
		buffalo box					
1984	39 1/2'	1"-C-ST. To Curb					
Exist							
1983	91'	1" Copper To house					
	1	1"-Union-3-Part or Comp.					

DATE _____

TOWN OF LEXINGTON — BOARD OF PUBLIC WORKS

WATER DIVISION

Sketch of Service Here

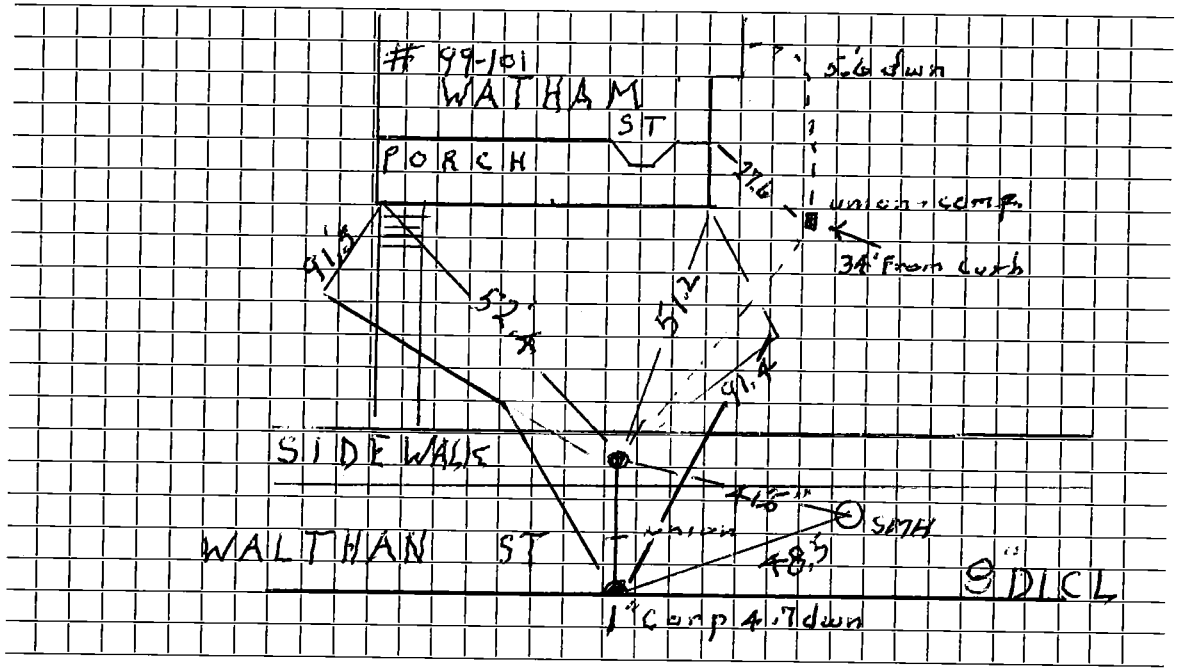

Connection made in ..... Street. Work completed 8-10-11 Grannese

Remarks: Curb 4'8" down