H.B.M.16010

WATER SERVICE RECORD

Name [redacted] **Service No.**

Address 37 Watertown Street

Location

Repair—[redacted]

Date		Material	Amount	Total	Date			Amount
9-30-	40							
	42'	1" Copper						
	1	1" C. X 3/4" I. Stop + Waste						
					[redacted]		NON CHARGE	[redacted]
					10-7-60		Labor [redacted]	20.70
						10'	3/4" Copper tubing @.42	4.20
						1	3/4" C Corp Cock	4.91
						1	3/4" C 3 part union	2.41
						1	hr. Town Shovel @6.50	6.50
						2	hrs. Trucking @.75	1.50
								40.22
						(Service to 12" Main)		

DATE _____

TOWN OF LEXINGTON — BOARD OF PUBLIC WORKS

WATER DIVISION

Sketch of Service Here

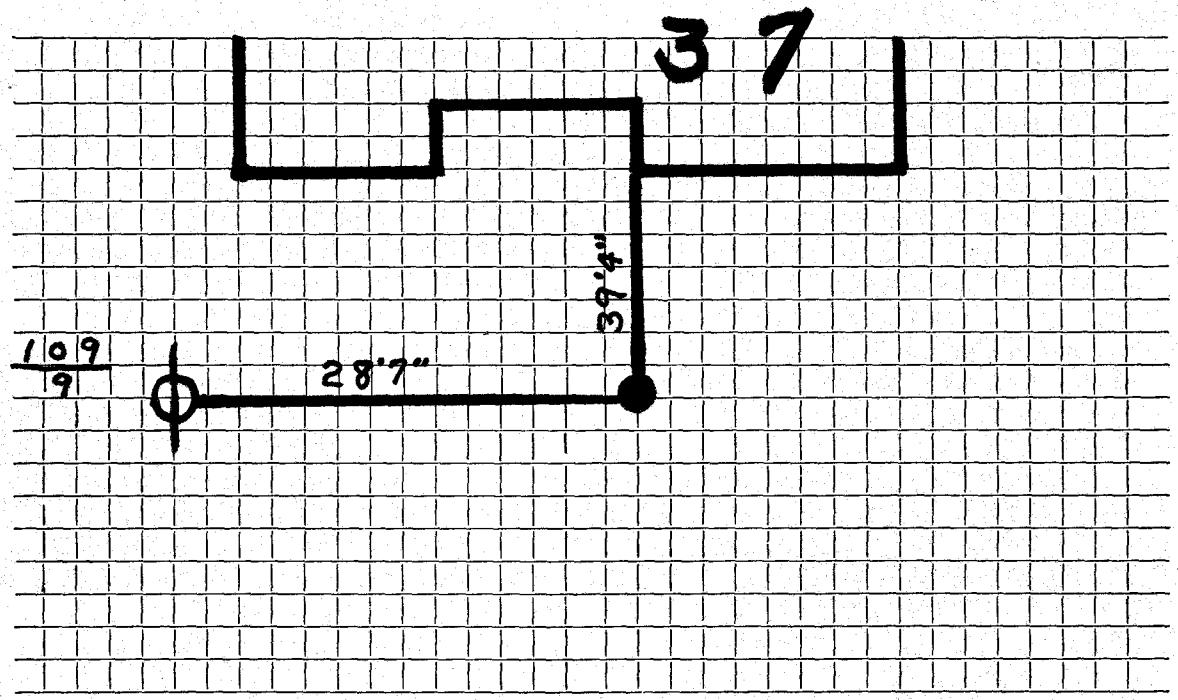

Connection made in ..... Street. Work completed .....

Remarks: .....

.....

.....