WATER SERVICE RECORD

Name | **Service No.**

Address 10 Webb ST

Location Lot 88

Repair—Renewal—New Service

Date		Material	Amount		Total		Date		Deflice	Amount	
7/1/85		3/4 Copper					9/5/07	17'	1" Copper		
		3/4 x 3/4 S+W							1" Corp		
									1" Curb Stop		
									1" x 3/4" Red		
									buffalo box		

DATE _____

TOWN OF LEXINGTON — BOARD OF PUBLIC WORKS

WATER DIVISION

Sketch of Service Here

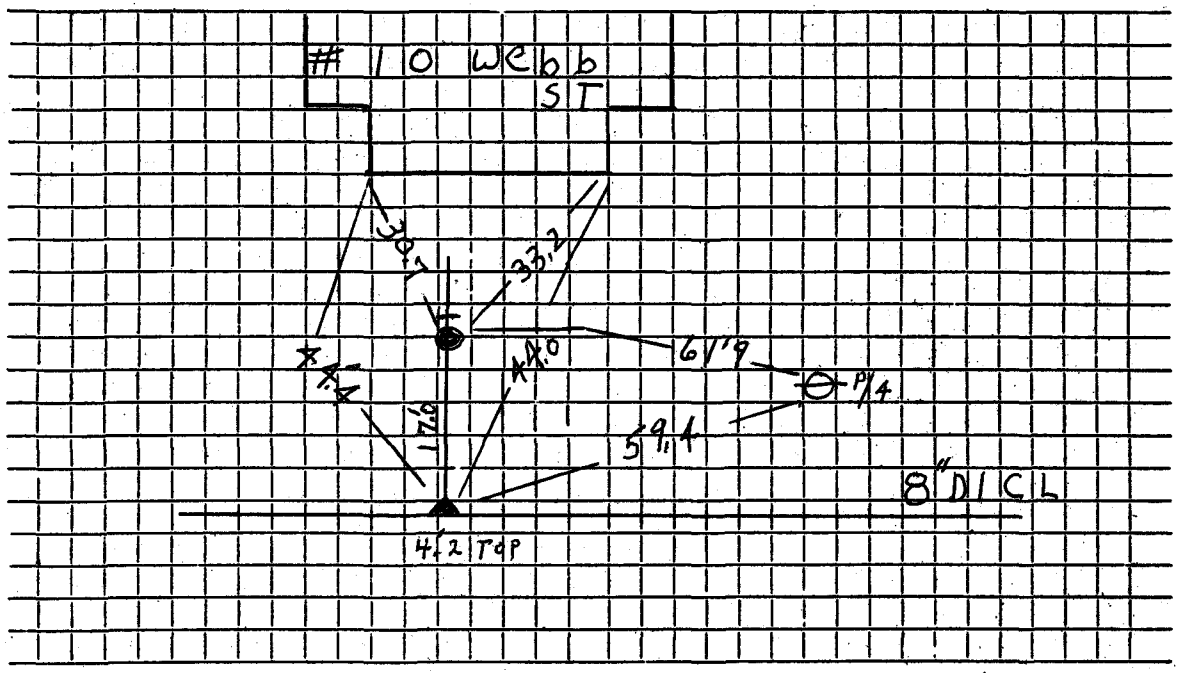

Connection made in ..... Street. Work completed 9/5/07 Deflice

Remarks: .....

.....

.....