# WATER SERVICE RECORD

**Name** | **Service No.**

**Address** 17 Webb ST

**Location** LoT 102

**Repair—Renewal—New Service**

| Date | | Material | Amount | | Total | | Date | | Deflice | Amount | |
|---|---|---|---|---|---|---|---|---|---|---|---|
| 12/9/61 | 3/4" | Copper | | | | | 9/5/07 | 26' | 1" Copper | | |
| | | S&W | | | | | | | 1" Corp | | |
| | | | | | | | | | 1" Curb Stop | | |
| | | | | | | | | | 1"x 3/4 Bed | | |
| | | | | | | | | | bufflo box | | |

DATE _____

TOWN OF LEXINGTON — BOARD OF PUBLIC WORKS

# WATER DIVISION

**Sketch of Service Here**

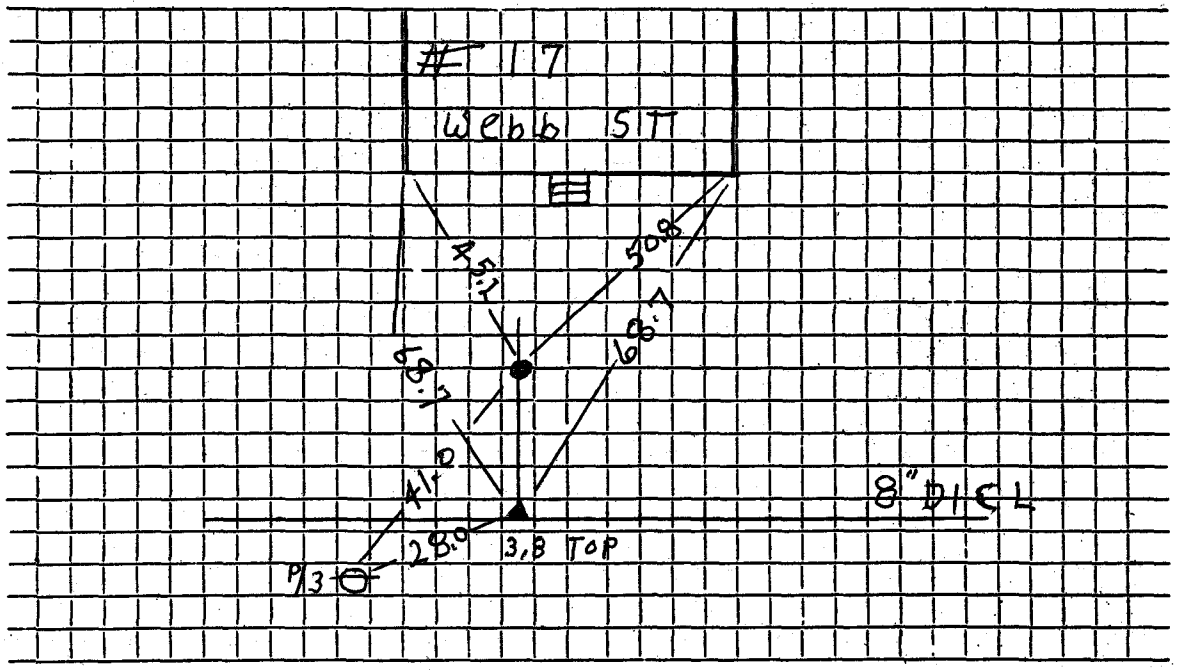


Connection made in ..... Street. Work completed 9/5/07 Defl. c.c.

Remarks: .....

.....

.....