WATER SERVICE RECORD

Name

Service No.

Address 19 Weston Street

Location

Repair—Renewal—New Service

Date		Material	Amount		Total		Date			Amount	
5/13/86	174'	1"Copper									
	1	1" Corp									
	1	1" Curb									
									outside		
							5/13/86	32½'	1" Copper		
								1	1" x 3/4" 3 Part Union		
								2	1" 3 part union		

DATE _____

TOWN OF LEXINGTON — BOARD OF PUBLIC WORKS

WATER DIVISION

Sketch of Service Here

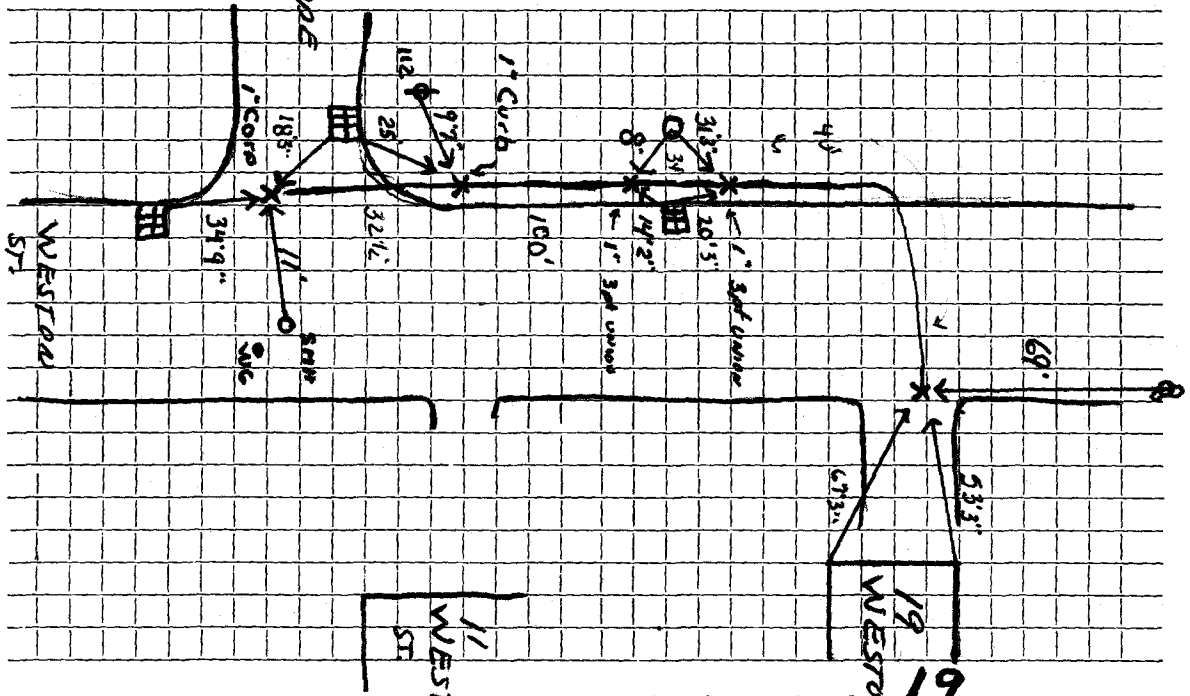

Connection made in ....., ... street. Work completed .....

Remarks: .....

.....

.....

WATER SERVICE RECORD

Name **Service No.**

Address 19 WESTON STREET

Location CORPORATION OFF 8" MAIN ON SHADE ST [BETWEEN T&S FOR HYDRANT & 8" GATE OFF T&S ON 12" MAIN]

Repair—Renewal—New Service

Date	Material	Amount	Total	Date			Amount
				8-2-1999			
					4'	1" COPPER BTW CORPORATION & UNION	
					1	CORPORATION	
					1	UNION	

DATE 8-2-1999

TOWN OF LEXINGTON — BOARD OF PUBLIC WORKS

WATER DIVISION

Sketch of Service Here

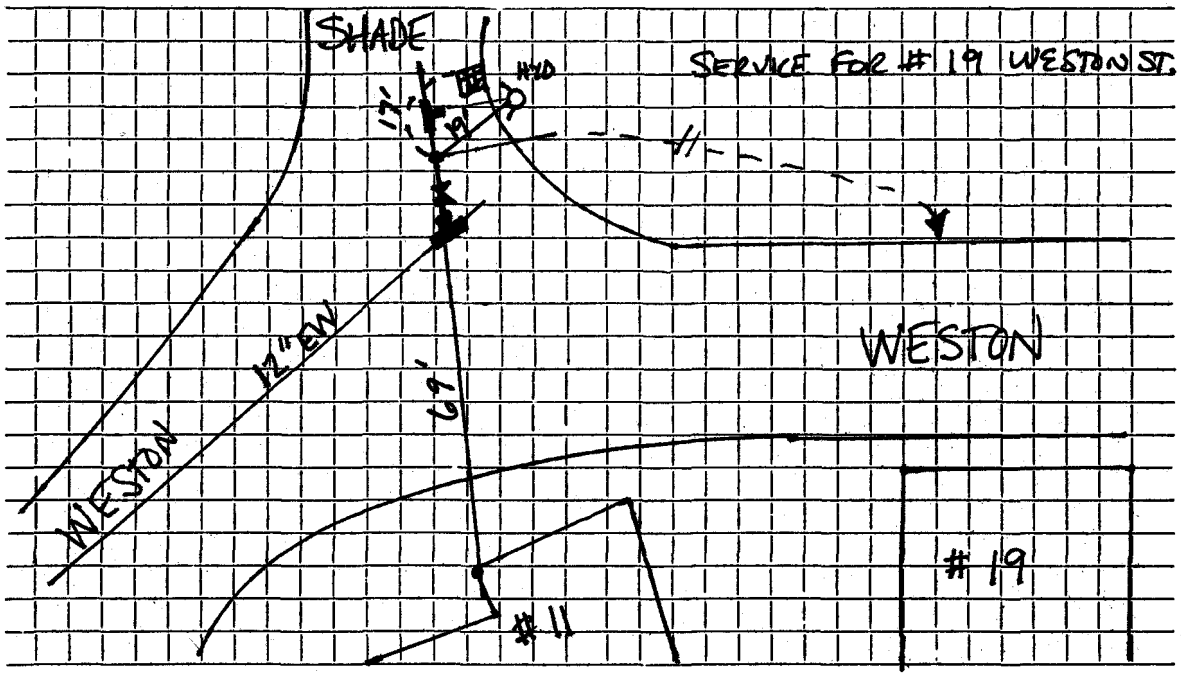

Connection made in 8" MAIN ON SHADE STREET BTW HYDRANT & GATE Street. Work completed NEW CORPORATION, UNION

Remarks: