WATER SERVICE RECORD

Name

Service No. 2391

Address 15 Wheeler RD.

Location Lot 126

Repair—Renewal—New Service J McLaughlin

Date		Material	Amount		Total		Date			Amount	
4/3/07	70'	1" Copper					9/29/54	19'	3/4 Copper		
	1	3/4 x 1" Increaser							3/4 Corp		
		buffalo-box							3/4 Curb Stop		

DATE _____

TOWN OF LEXINGTON — BOARD OF PUBLIC WORKS

WATER DIVISION

Sketch of Service Here

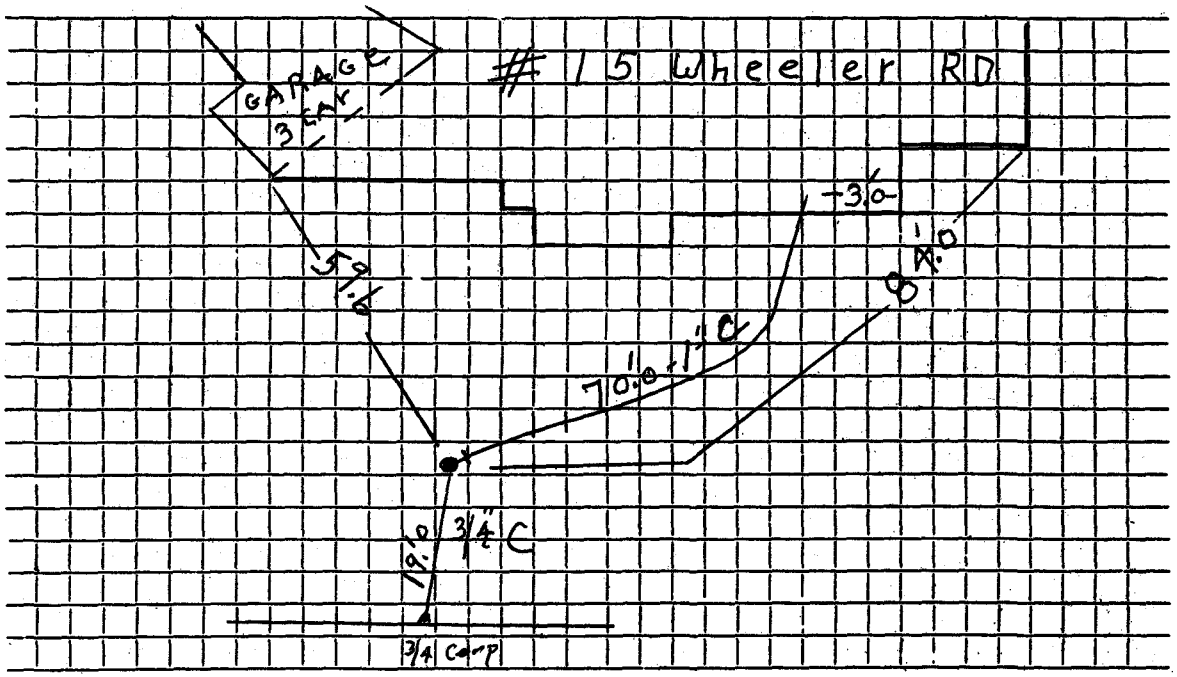

Connection made in ..... Street. Work completed .....

Remarks: .....

.....

.....