WATER SERVICE RECORD

Name **Service No.**

Address 13 White pine Lane

Location Curb Stop in Driveway Tap in Road

Repair—Renewal—New Service

Date	Material	Amount	Total	Date		Amount
11-24-20	3/4" To 1" Adapter	1				
	1" curb Stop	1				
	1" copper	70'6"				
	1" Corporation	1				
	curb Box Buffalow	1				

DATE 11-24-20

TOWN OF LEXINGTON — BOARD OF PUBLIC WORKS

WATER DIVISION

Sketch of Service Here

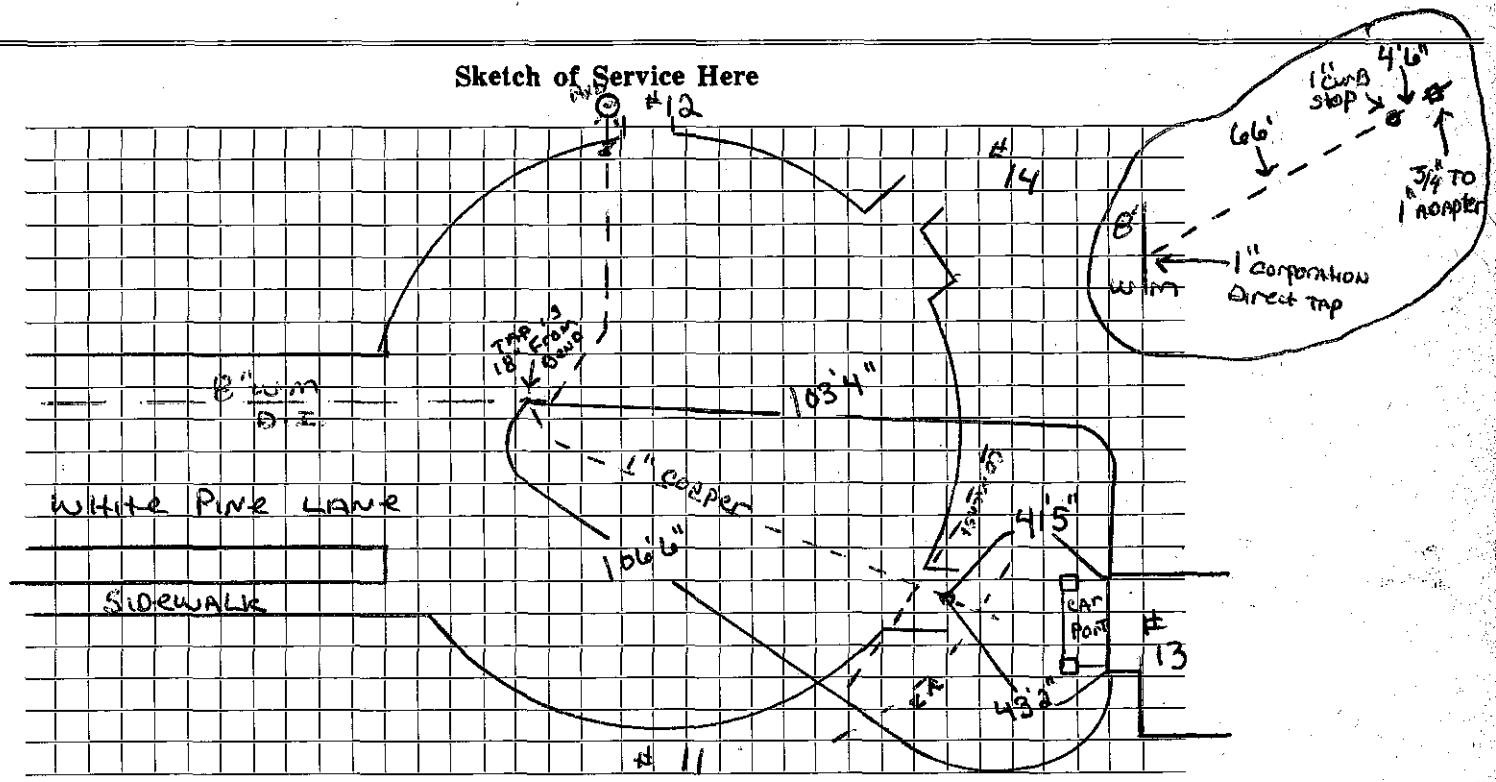

Connection made in ..... Street. Work completed INSTALLED NEW MAIN TO CURB STOP

Remarks: .....

.....

.....