WATER SERVICE RECORD

Name

Service No. 2637

Address 52 Williams RD

Location Lot 260

Repair—Renewal—New Service J.McI

Date		Material	Amount		Total		Date			Amount	
10/13/07	58'	1" Copper					5/25/53	9'	3/4 Copper		
		1 x 3/4 Red.							3/4 Corp		
		buffalo box							3/4 Curb Stop		

DATE _____

TOWN OF LEXINGTON — BOARD OF PUBLIC WORKS

WATER DIVISION

Sketch of Service Here

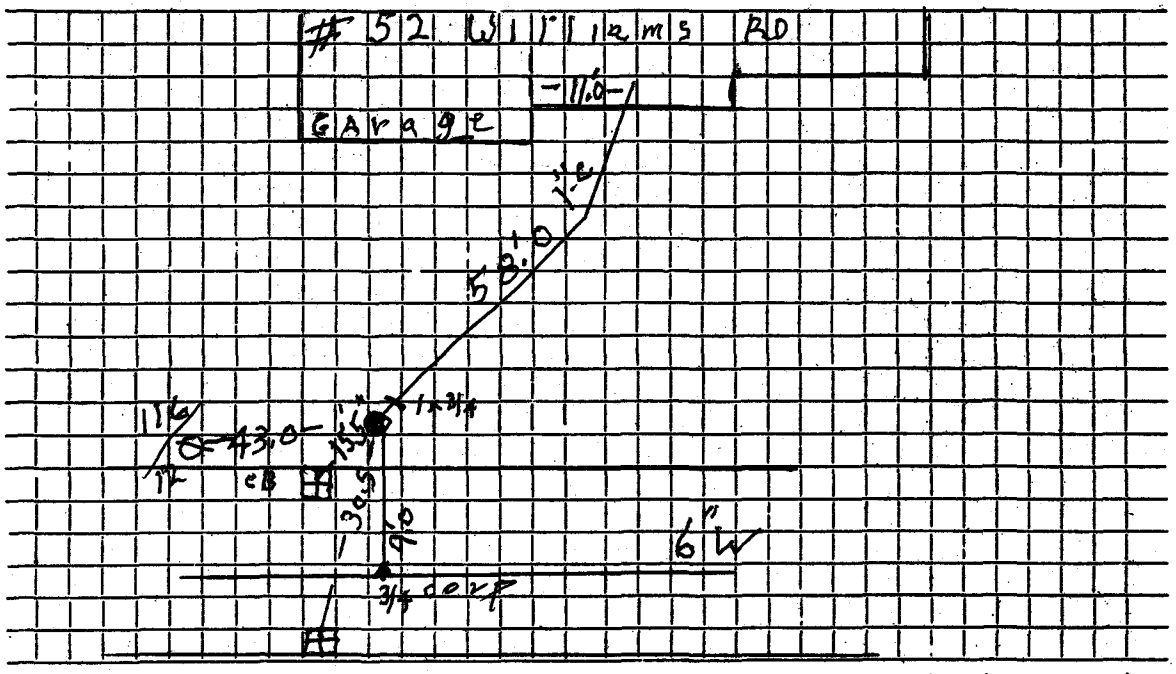

Connection made in ..... Street. Work completed 10/13/07 J. McL.

Remarks: .....