WATER SERVICE RECORD

Name | **Service No.**

Address 196 Woburn ST

Location Lot 86A

Repair—Renewal—New Service

Date		Material	Amount		Total		Date			Amount	
Existing		1½" Copper					8/8/07	20'	1½" Copper		
								1	1½"×8" Service Saddle		
								1	1½" Corp		
								1	1½" Curb Stop		
								1	1½ Union		
								1	Rd way box		

DATE _____

TOWN OF LEXINGTON — BOARD OF PUBLIC WORKS

WATER DIVISION

Sketch of Service Here

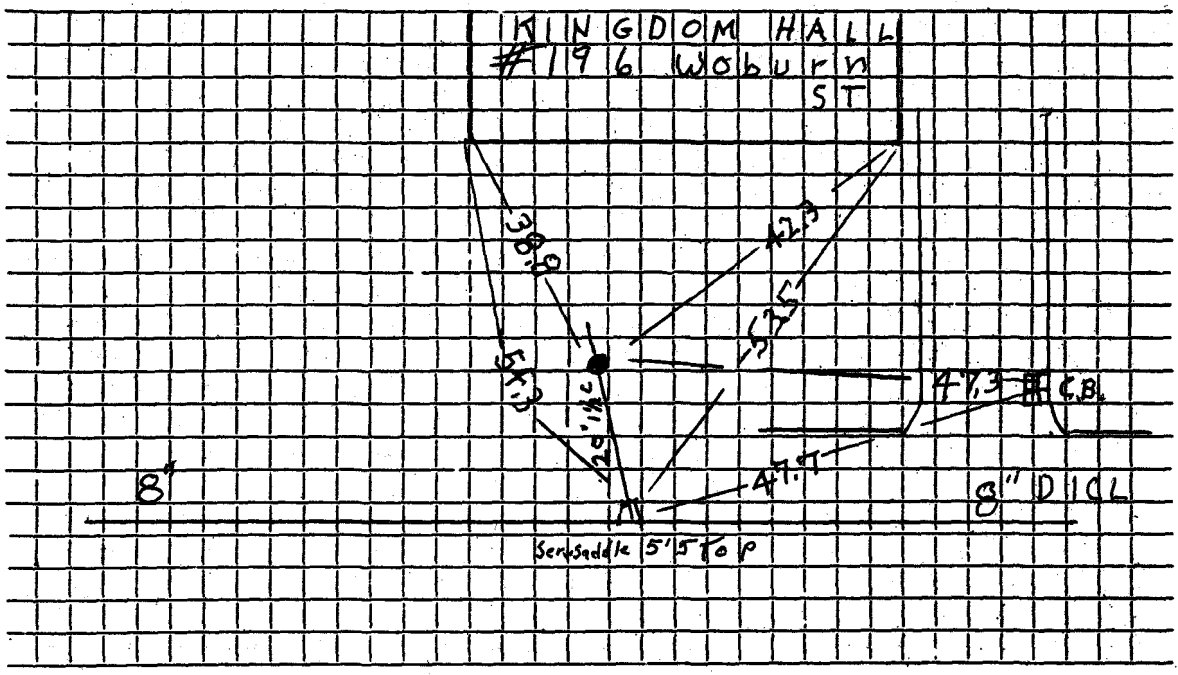

Connection made in ..... Street. Work completed 8/8/07 Defline

Remarks: .....