WATER SERVICE RECORD

Name | **Service No.**

Address 253 Woburn ST

Location Lot 121

Repair—Renewal—New Service

Date		Material	Amount		Total		Date		Deflice	Amount	
2/9/56	60'	3/4 Copper					7/31/07	23.5	1" Copper		
		3/4 x 1/2 S & W							1" Corp		
									1" Curb Stop		
									1" x 3/4 Red		
									buffalo box		

DATE _____

TOWN OF LEXINGTON — BOARD OF PUBLIC WORKS

WATER DIVISION

Sketch of Service Here

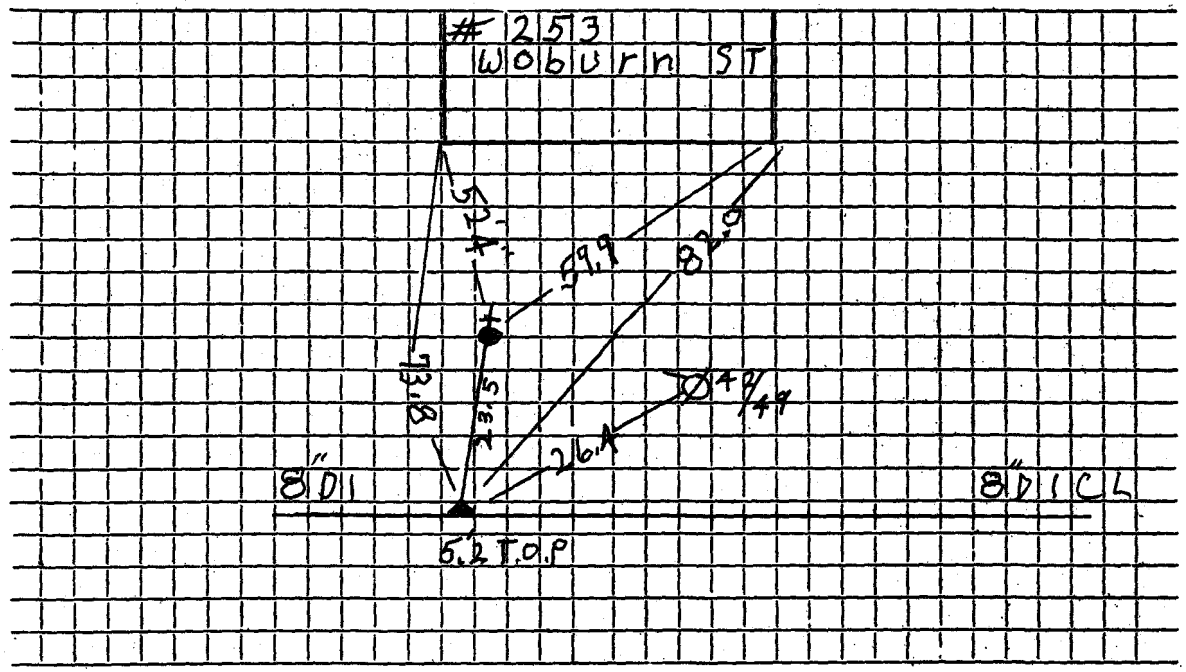

Connection made in ..... Street. Work completed 7/31/07 Deflice

Remarks: .....