WATER SERVICE RECORD

Name **Service No.**

Address 259 Woburn St.

Location Lot 120

Repair—Renewal—New Service

Date		Material	Amount		Total		Date		Deflice	Amount	
4/8/54	60'	3/4 Copper					7/30/07	25.5	1" Copper		
		3/4x1/2 Screw							1" Comp		
									1" Curb Stop		
									1"x 3/4 Red.		
									buffalo box		

DATE _____

TOWN OF LEXINGTON — BOARD OF PUBLIC WORKS

WATER DIVISION

Sketch of Service Here

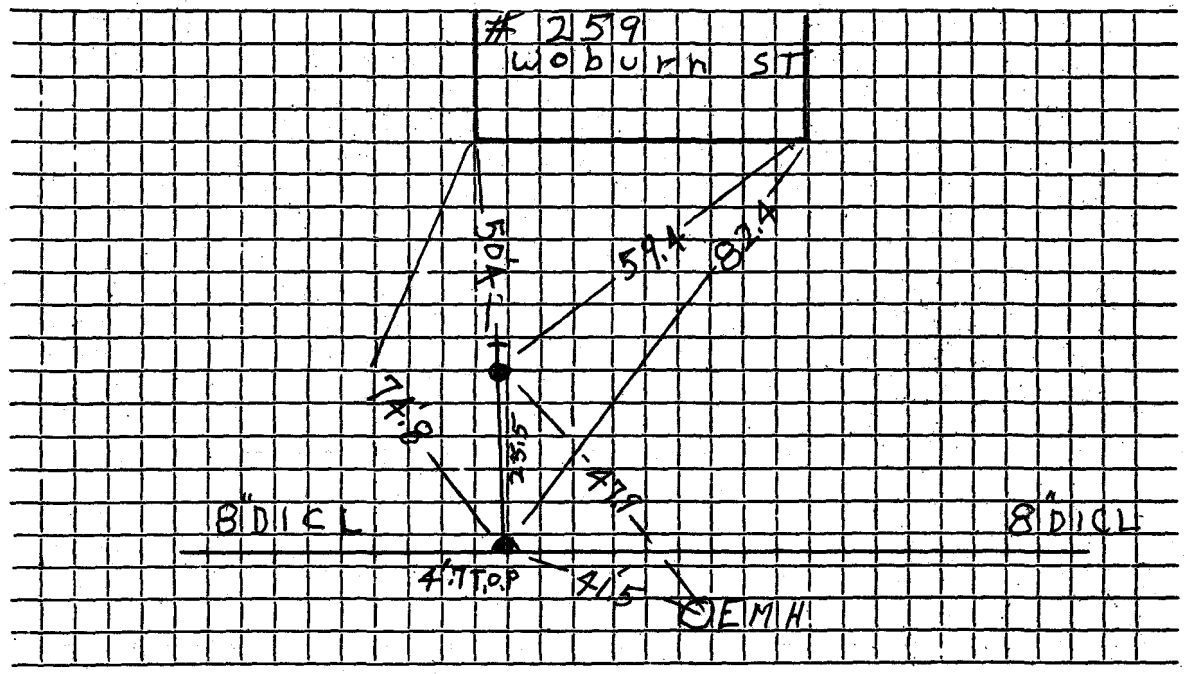

Connection made in ..... Street. Work completed 7/30/07 Deflice

Remarks: .....