WATER SERVICE RECORD

Name | **Service No.**

Address 280 Woburn ST

Location Lot 19

Repair—Renewal—New Service

Date		Material	Amount	Total	Date		Deflex	Amount
7/11/55	57'	3/4 Copper			7/27/07	16.5	1" Copper	
		3/4 x 1/2 S&W					1 Corp	
							1 Curb Stop	
							1" x 3/4" Red	
							buffalo box	

DATE _____

TOWN OF LEXINGTON — BOARD OF PUBLIC WORKS

WATER DIVISION

Sketch of Service Here

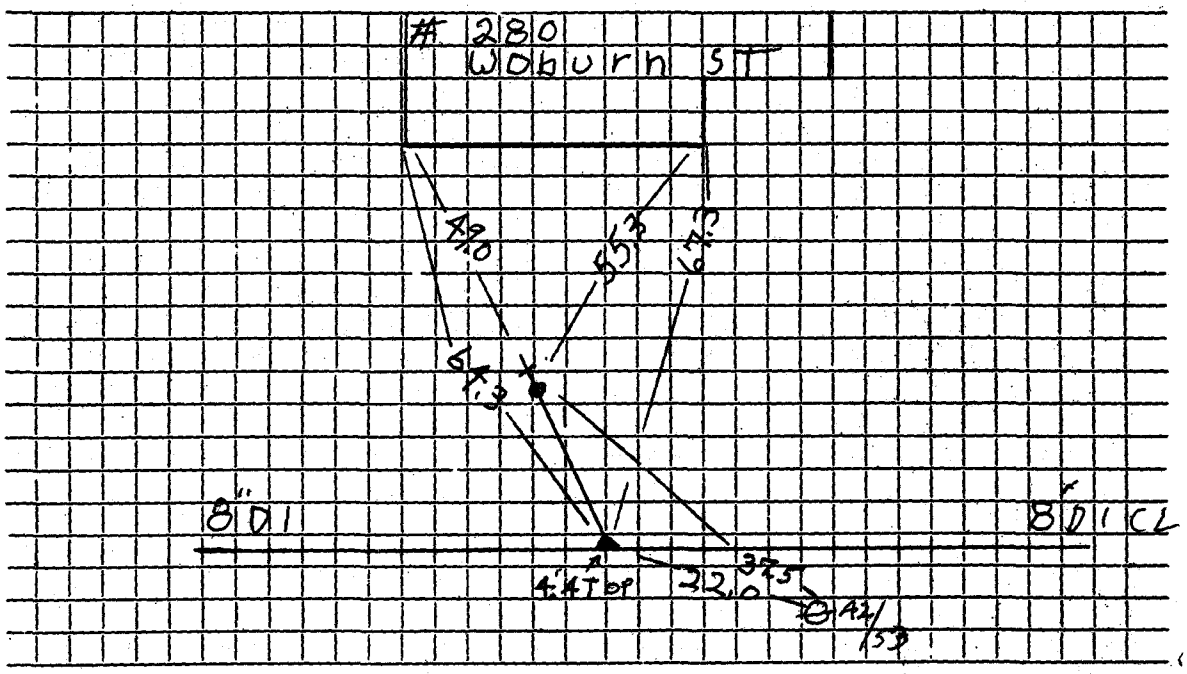

Connection made in ..... Street. Work completed 7/27/07 Deflice.....

Remarks: .....

.....

.....