WATER SERVICE RECORD

Name | **Service No.**

Address 295 W

Location LoT 114

Repair—Renewal—New Service

Date		Material	Amount	Total	Date		Defice	Amount
5/10/49	48'	3/4 Copper			7/25/07	22.5	1" Copper	
	1	3/4 Union (3 part)					1" Corp	
		3/4 x 1/2 Sxw					1" Curb STop	
							1" x 3/4 Red	
							buffalo box	

DATE _____

TOWN OF LEXINGTON — BOARD OF PUBLIC WORKS

WATER DIVISION

Sketch of Service Here

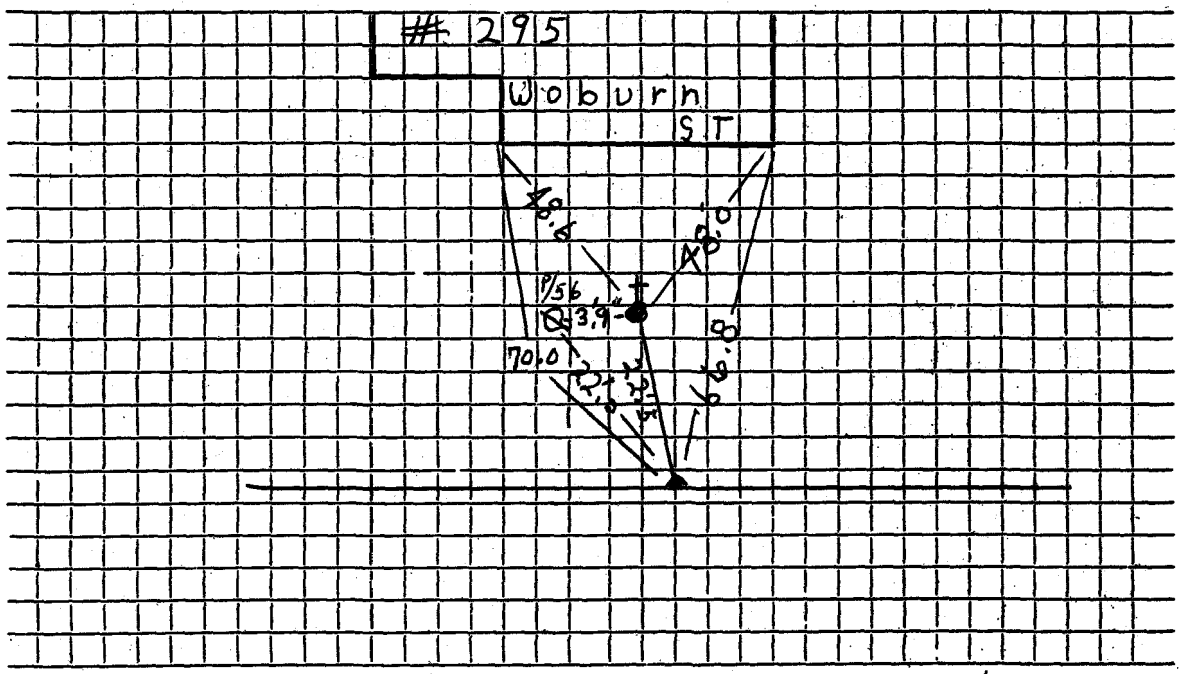

Connection made in ..... Street. Work completed 7/25/07 Deflice

Remarks: .....