H.B.M.16010

WATER SERVICE RECORD

Name | **Service No.**

Address 395 Woburn Street

Location

Repair—Renewal—New Service W.O. # 7277

Date	Material	Amount	Total	Date			Amount	
						OUTSIDE		
				12/17/69		Labor	20	92
					12'	3/4" Copperpipe .79	9	48
					1	3/4" Corporation	9	57
					1	3/4" Curb cock	11	32
						Box & Rod	5	10
					1	Hr. Trucking	3	00
					2	Hr. Shovel 6.50	13	00
							72	39

DATE _____

TOWN OF LEXINGTON — BOARD OF PUBLIC WORKS

WATER DIVISION

Sketch of Service Here

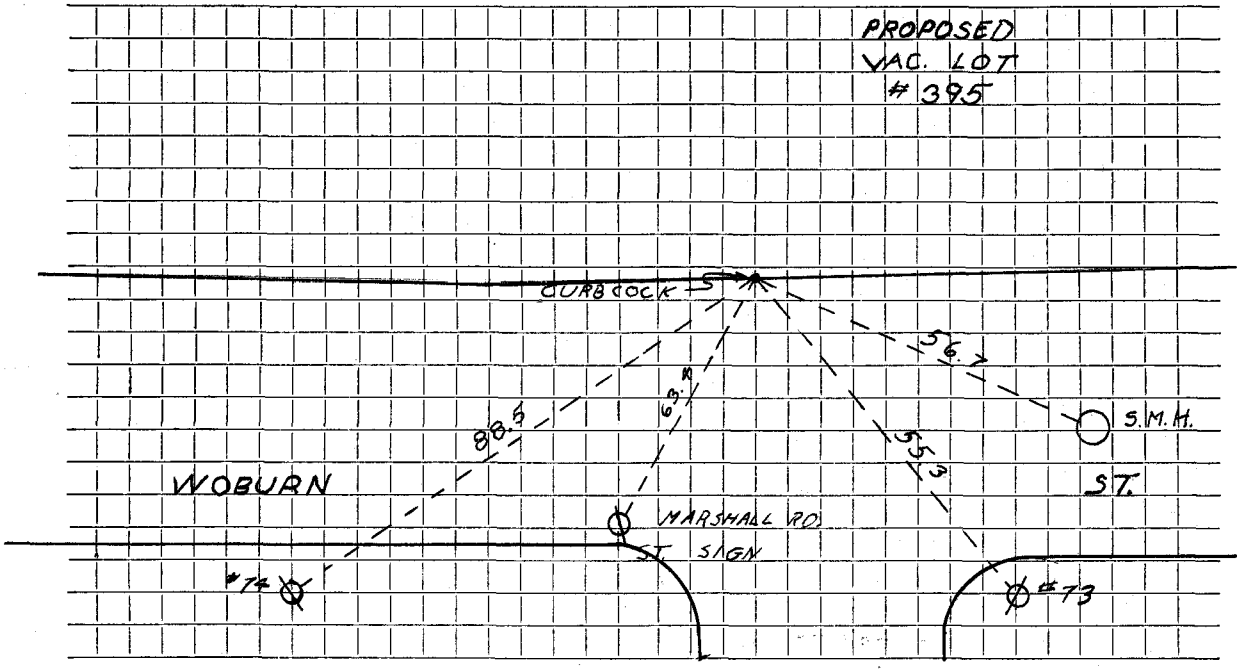

Connection made in ..... Street. Work completed .....

Remarks: .....

.....

.....