WATER SERVICE RECORD

Name | **Service No.**

Address 47 Woburn ST

Location LOT 272

Repair—Renewal—New Service

Date		Material	Amount		Total		Date		Defiss	Amount	
10/27/31	22'	3/4 Copper					9/17/07	27.7	1" Copper		
		3/4x1/2 S+W						1	1" Corp		
								1"	Curb Stop		
								1	1"x3/4 Rect		
									buffle box		

DATE _____

TOWN OF LEXINGTON — BOARD OF PUBLIC WORKS

WATER DIVISION

Sketch of Service Here

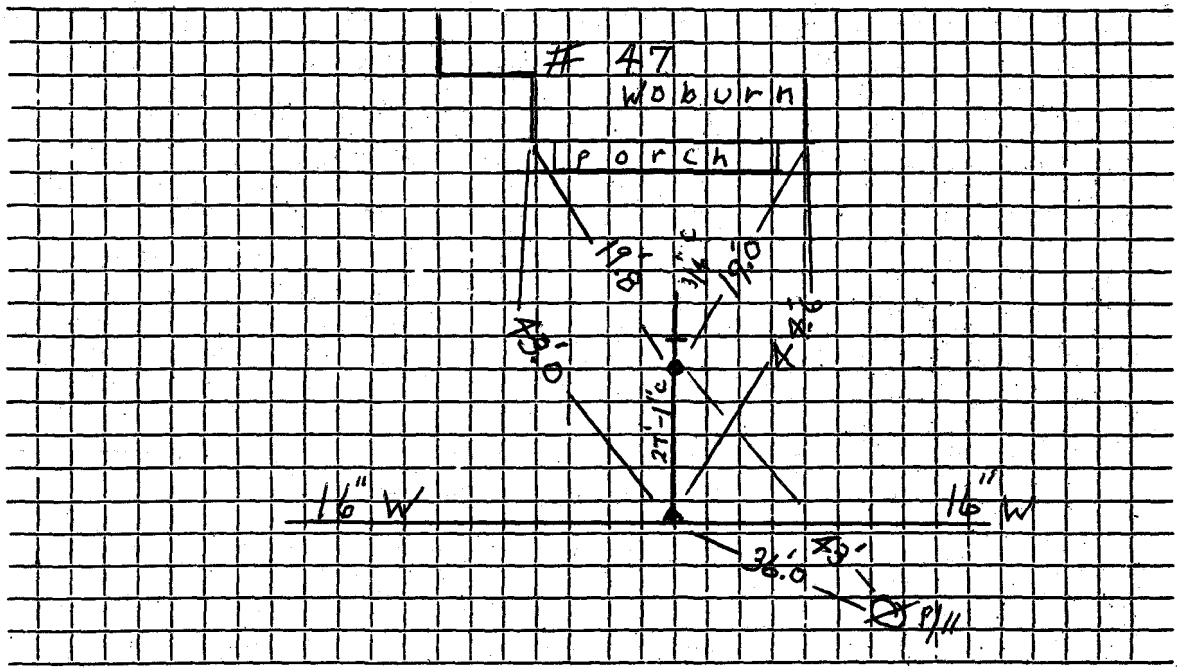

Connection made in ..... Street. Work completed 9/17/07 Defline

Remarks: .....