H.B.M.16010

WATER SERVICE RECORD 1351

#5484

Name Benjamin Gott **Service No.** 282 [redacted]

Address 57 Woburn Street, Lexington

Location Lot 255

~~Repair~~—~~Renewal~~—New Service **Water on-Meter in** Comm. 10-29-56

Date	Material	Amount	Total
9/17/56	Labor	1 90	
	10% Overhead	20	2 10
	30'-3/4" Copper tubing @.4850		14 55
	1-3/4"C x ½ I.W.H. stop & waste		4 96
	1 hr. trucking @.75		75
			22 36

Date		Amount
9-10-56	Deposit	$ 50 00
10-29-56	Refund	27 64
	NON CHARGE	$ 22 36
	Curb to Main	1 90
	10'-3/4" Copper tubing @.4850	4 85
	1-3/4" C Corp Cock	4 64
	1-3/4" C Curb Cock	5 94
	1 Box & Rod	4 62
	1-½ straight tail piece	50
	1-½ offset tail piece	50
		22 95
10-10-65	Roots	

DATE_____

TOWN OF LEXINGTON — BOARD OF PUBLIC WORKS

WATER DIVISION

Sketch of Service Here

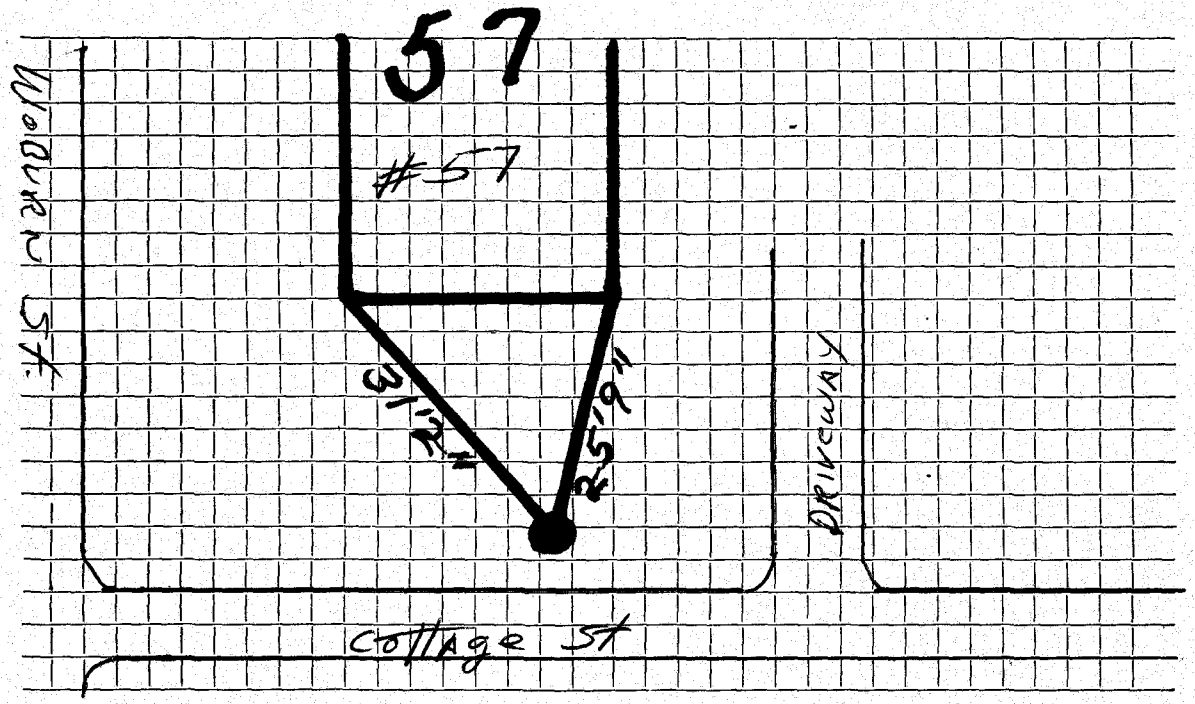

Connection made in ..... Street. Work completed .....

Remarks: .....

.....

.....