WATER SERVICE RECORD

Name | **Service No.**

Address 65 Woburn ST

Location LOT 252

Repair—Renewal—New Service

Date		Material	Amount	Total	Date		Deflice	Amount
8/23/45	10'	3/4" Copper			9/14/07	24'	1" Copper	
	1	3/4 x 3/4 S & W					1" Corp	
	1	3/4 x 1/2 Bush					1" Curb Stop	
							1" x 3/4" Red.	
							buffalo box	

DATE _____

TOWN OF LEXINGTON — BOARD OF PUBLIC WORKS

WATER DIVISION

Sketch of Service Here

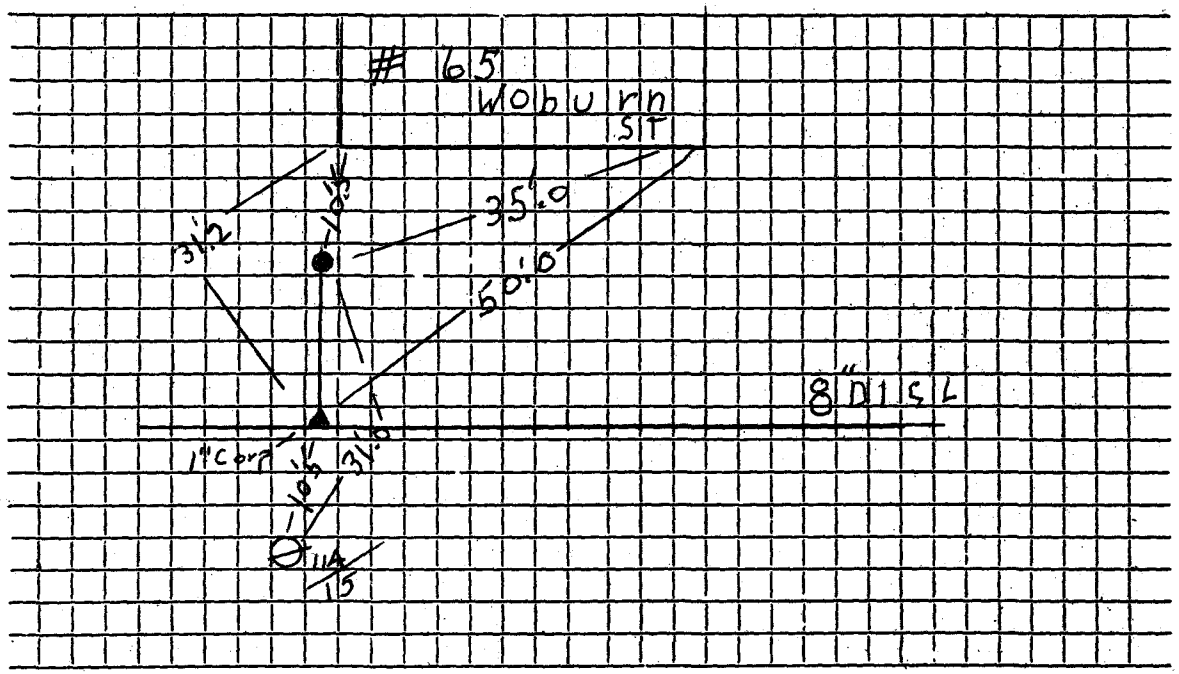

Connection made in ..... Street. Work completed 9/14/07 Deflice .....

Remarks: .....

.....

.....