WATER SERVICE RECORD

Name **Service No.**

Address [redacted]-66 Woburn ST

Location LOT 241

Repair—Renewal—New Service

Date		Material (Renewal)	Amount	Total	Date		Deflice	Amount
9/9/87	38'	3/4 Copper			9/17/07	10.5	1" Copper	
~~VOID~~	?	3/4 x 3/4 Valve				1	1" Corp	
						1	1" Curb Stop	
INSIDE		MAY be 1" copper					bufflebox	
EXIST	1"	Curb Stop						

DATE _____

TOWN OF LEXINGTON — BOARD OF PUBLIC WORKS

WATER DIVISION

Sketch of Service Here

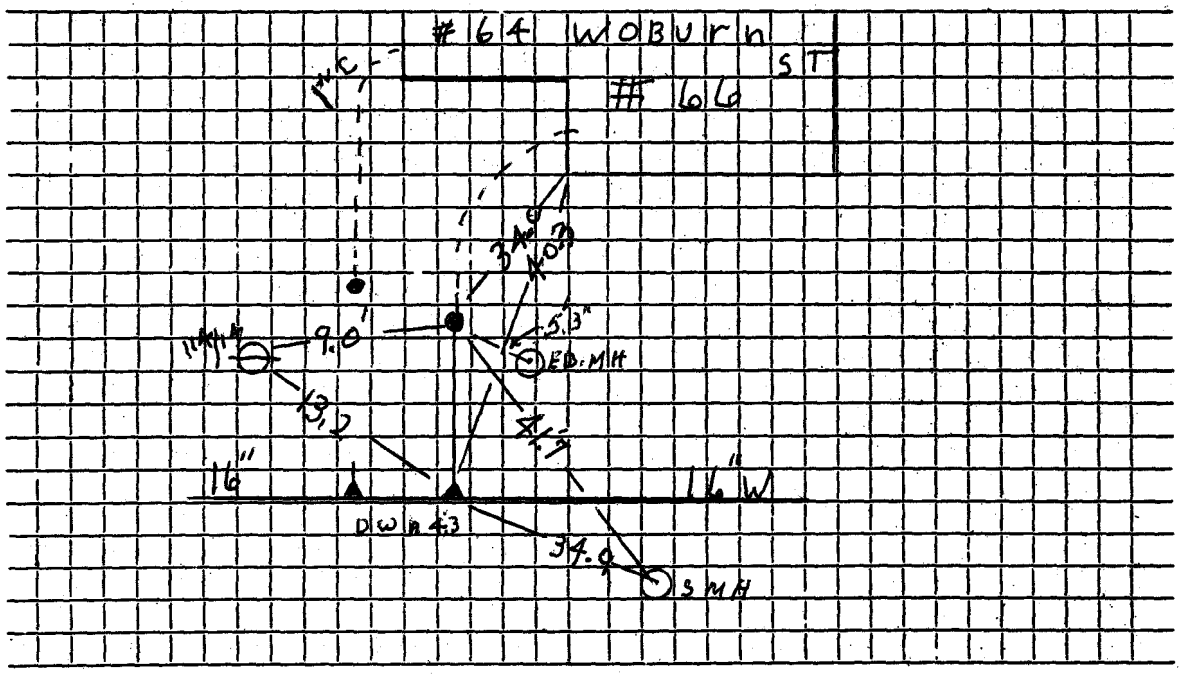

Connection made in ..... Street. Work completed Sept. 07 Defelice

Remarks: Keep Existing curb stop due to dust bank.