WATER SERVICE RECORD

Name | **Service No.**

Address 68 Woburn ST

Location Lot 242

Repair—Renewal—New Service

Date		Material	Amount		Total		Date		Deflice	Amount	
1943	83'	C.L.I.P					9/11/07	11.6	1" Copper		
									1" Corp		
									1" Curb Stop		
								P	1 x 3/4 Rod		
									baffle-box		

DATE _____

TOWN OF LEXINGTON — BOARD OF PUBLIC WORKS

WATER DIVISION

Sketch of Service Here

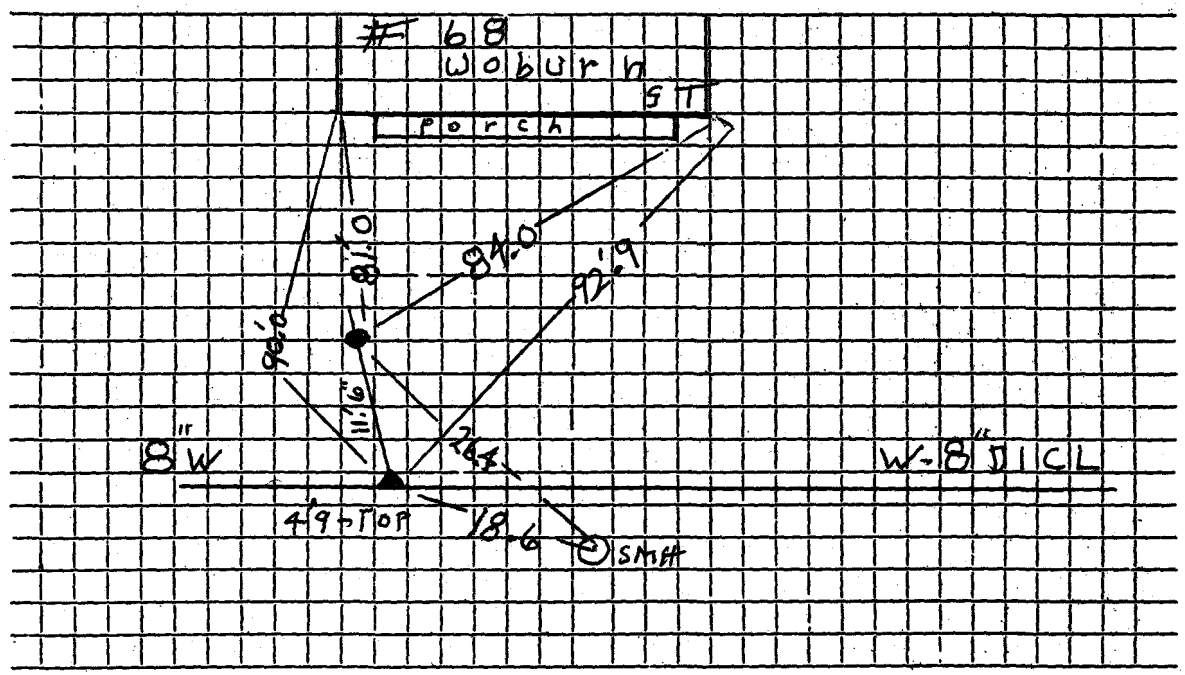

Connection made in ..... Street. Work completed Sept 11/07 Defline

Remarks: .....