WATER SERVICE RECORD

Name | **Service No.**

Address 69 Woburn ST

Location LOT 251 B

Repair—Renewal—New Service

Date		Material	Amount		Total		Date		Defice	Amount	
5/6/41	22'	3/4 Copper					9/13/07	2½	1" Copper		
		3/4							1" Corp		
									1 Curb Stop		
									1"x3/4 Red		
									buffalo box		

DATE _____

TOWN OF LEXINGTON — BOARD OF PUBLIC WORKS

WATER DIVISION

Sketch of Service Here

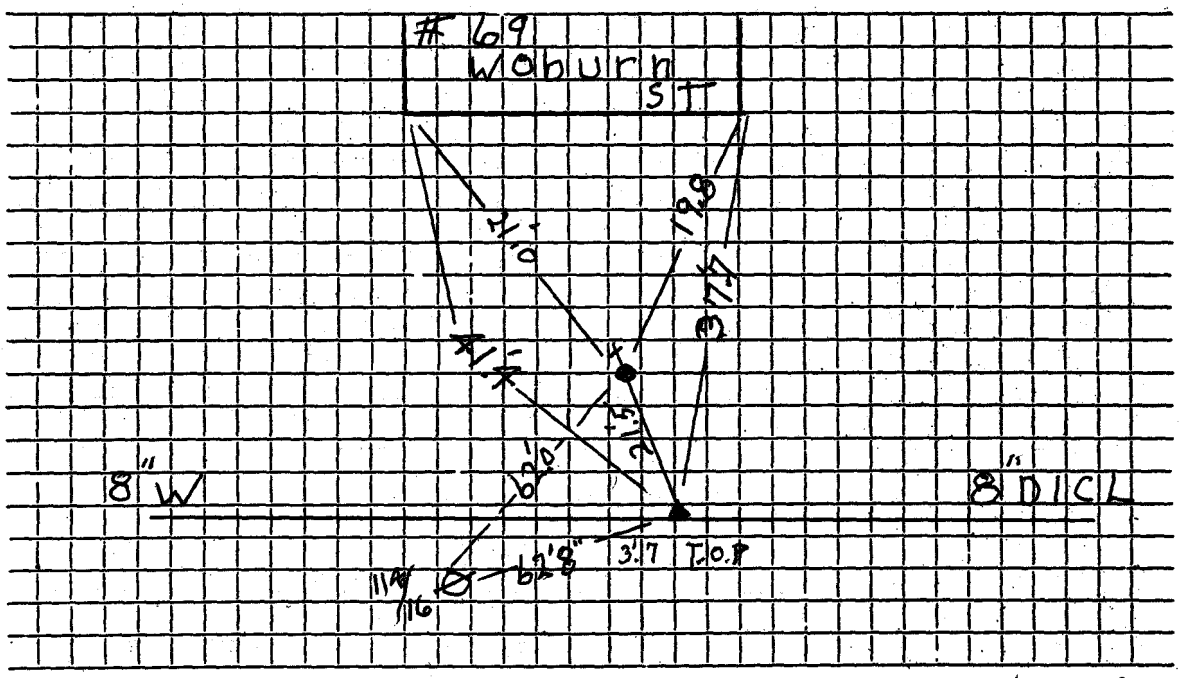

Connection made in ..... Street. Work completed Sept. 13/07 Deflice

Remarks: .....

.....

.....