WATER SERVICE RECORD

Name Homes Realty Corp. **Service No.**

Address #80 WOOD ST.

Location

Repair—Renewal—New Service McLaughlin #0204

Date		Material	Amount		Total		Date			Amount	
9/1	92	79 L.F. 1" COPPER									
		C/C & BOX									

DATE 9/1/92

TOWN OF LEXINGTON — BOARD OF PUBLIC WORKS

WATER DIVISION

Sketch of Service Here

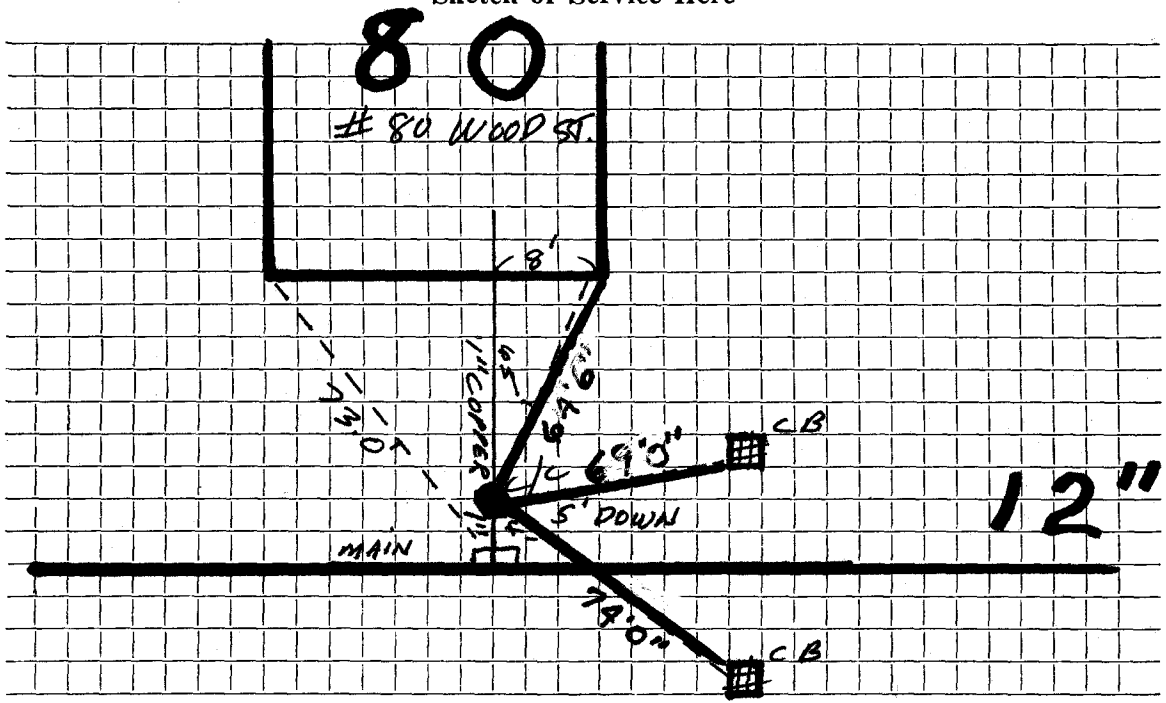

Connection made in #80 WOOD ST. Street. Work completed BY: MCLAUGHLIN

Remarks: INSPECTED: C.R.G.