main to curb - renewal

WATER SERVICE RECORD

Name

Service No.

Address 24 Woodland Road

Location Lexington, Mass.

~~Repair~~—Renewal—~~New Service~~

Date		Material	Amount	Total
		RENEWAL-Redmond #4167		
7/26/83	*36'*	*3/4" Copper tubing*		

Date		Amount	
	NON CHARGE		
7/20/51	Labor	2	98
	26' - 3/4" copper tubing@.326	8	48
	1 - 3/4" C. adapter	1	82
	1 - 3/4" C x 3/4" C. curb-cock	4	67
	1 hr. trucking		75
		18	70

HP-8855

DATE _____

TOWN OF LEXINGTON — BOARD OF PUBLIC WORKS

WATER DIVISION

Sketch of Service Here

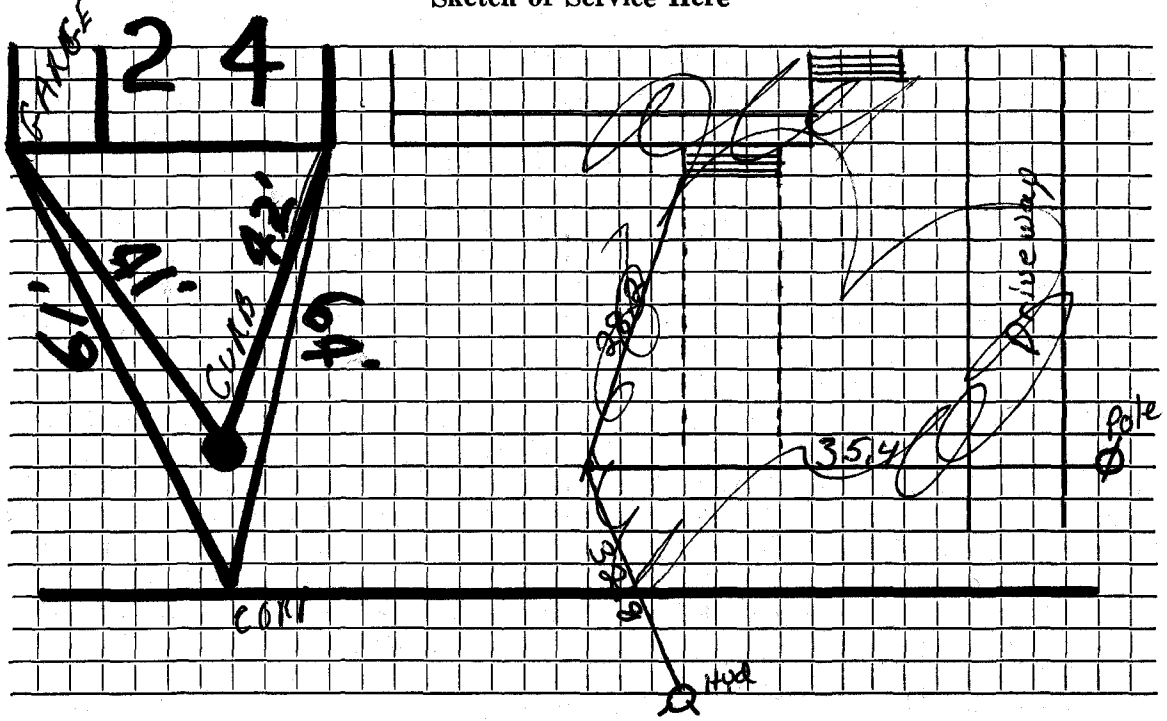

Connection made in ..... Street. Work completed .....

Remarks: .....

.....

.....