H.B.M.16010

5928

WATER SERVICE RECORD

Name Duffy Bros **Service No.**

Address 236 Worthen Road East

Location Lot #210

Repair—Renewal—New Service Bonanno - #592 & #707

Date		Material	Amount		Total		Date			Amount	
6/19/67	30'	3/4" Copper									
7-21-67	43.2'	3/4" Copper tubing									

DATE _____

TOWN OF LEXINGTON — BOARD OF PUBLIC WORKS

WATER DIVISION

Sketch of Service Here

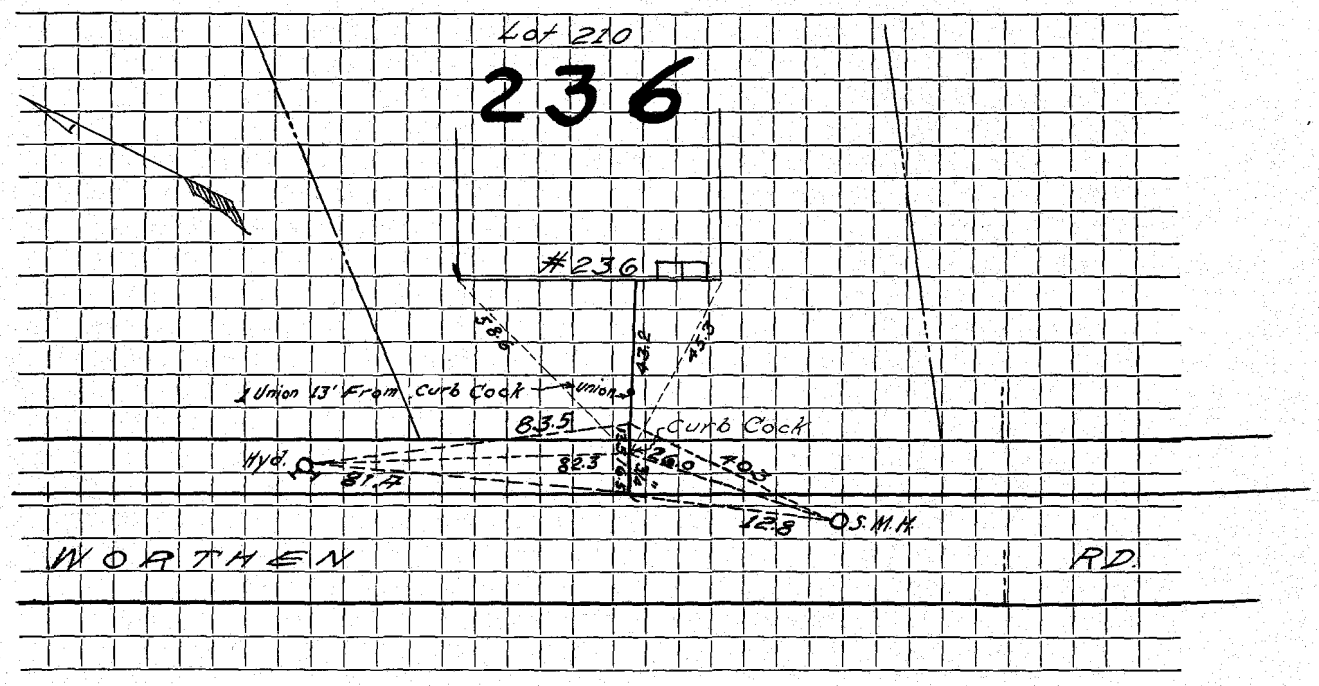

Connection made in ..... Street. Work completed .....

Remarks: .....

.....

.....