N.B.M.16010

WATER SERVICE RECORD

Name Duffy Brothers **Service No.**

Address 249 Worthen Road EAST #991

Location

~~Repair, Renewal~~ **New Service** John Flannery Permit #10

Date		Material	Amount		Total		Date			Amount	
9-28-65	43'	3/4" Copper tubing									
							6-28	65'			
								33'	3/4" Copper		

DATE _____

TOWN OF LEXINGTON — BOARD OF PUBLIC WORKS

WATER DIVISION

Sketch of Service Here

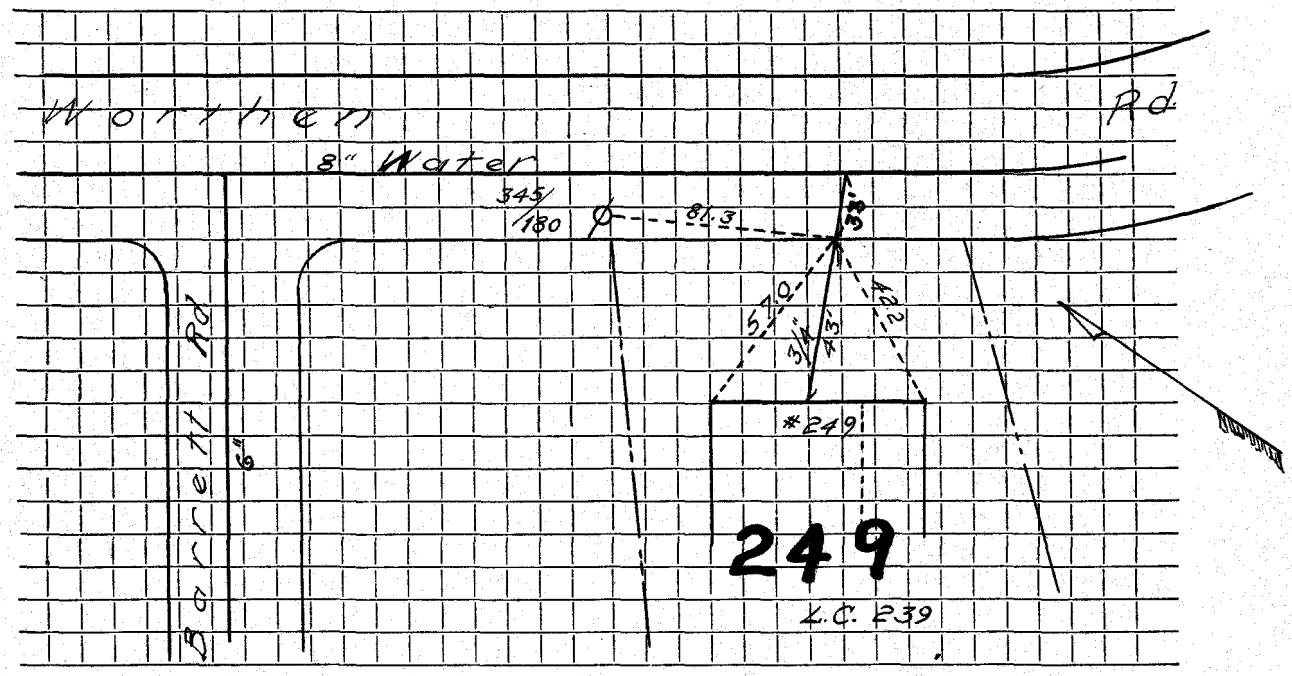

Connection made in ..... Street. Work completed .....

Remarks: .....

.....

.....