


\* Excavation and

Figure 14

pripline

within

TUNNELING UNDER ROOT ZONE

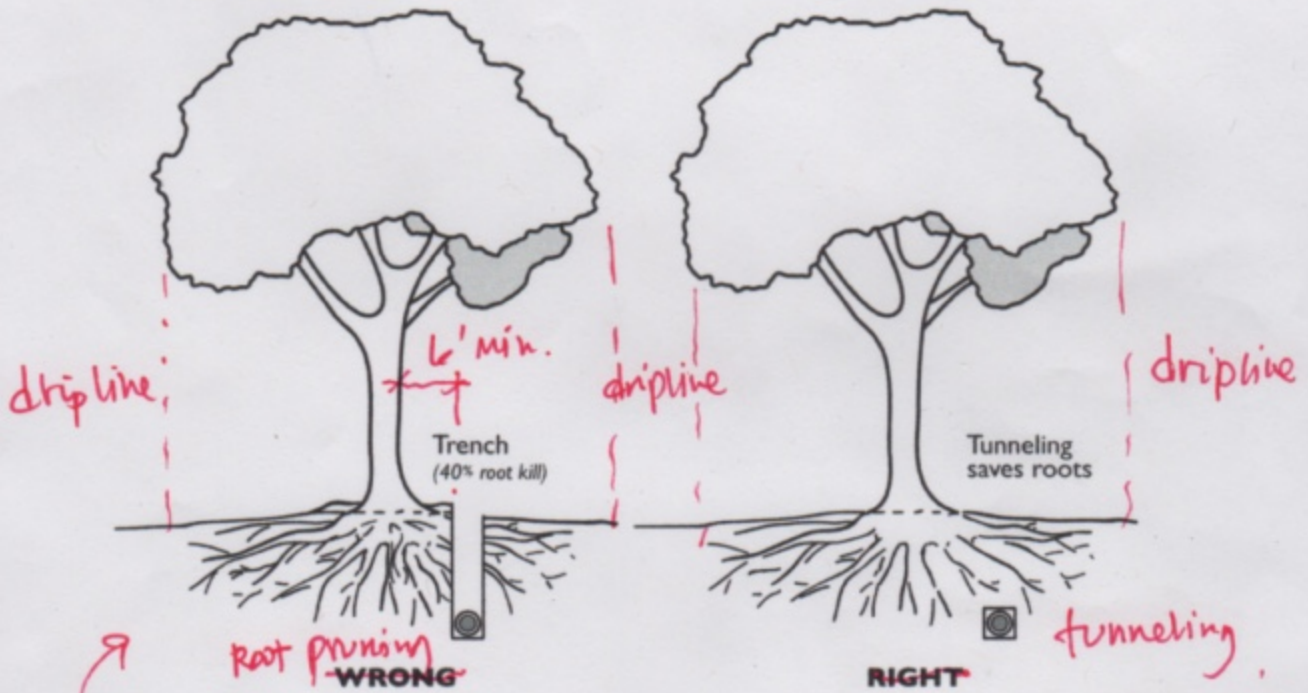

\* Graphic for root pruning?

Excavating

without proper root pruning

**AVOID SEVERING ROOTS**

Install utility lines around tree roots or tunnel under the root zone. Trenching kills all the roots outside the trench line. Posts and supporting beams can be substituted for footing and walls where proposed foundations conflict with tree roots.

can severely damage roots

root pruning language, maintenance & health care